



Rice

Form 252-A  
5M 4-32 MPC

KANSAS

Map No. \_\_\_\_\_ Sec. 32 Twp 19 R. 9-W

Well No. #1 Robinson 'A' Farm


Ramsey Company

825 Ft. from N. Line

\_\_\_\_\_ Ft. from S. Line

\_\_\_\_\_ Ft. from E. Line

300 Ft. from W. Line

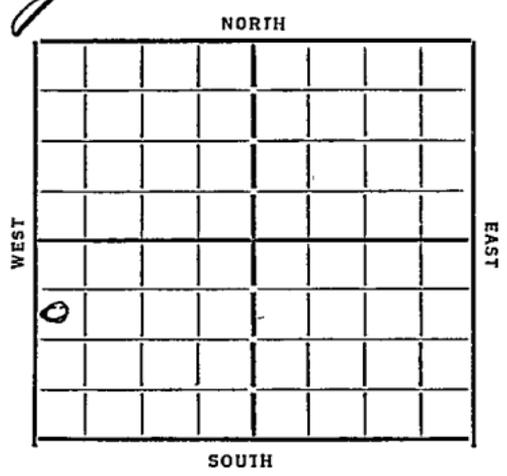

Date	REPORT
1933	
8/16	Rgn up
8/23	spud
8/30	12"-1182 hdy 1215
9/6	10" 1908 - 10 reg 2030'
9/13	8" 2507 " 2820
9/20	6" 3166 Siliceous 3235 - 2000' oil 4 hrs TD 3279
9/29	TD 3251 - 2150' oil - was swabbed
10/5	lower - showing water
	10/11
10/18	Siliceous 3235 TD 3257
	pump 1205 lbs.
	COMPLETED

Map No. 49 Sec. 32 Twp. 19 R. 9W

Well No. #1- Robinson 'A'

Ramsey Company

Contractor

SECTION PLAT

825 Ft. from N. Line  
 ..... Ft. from S. Line  
 ..... Ft. from E. Line  
300 Ft. from W. Line


FIRST REPORTS

Location.....

Rig up.....

Drilling and Remarks:

*Rig up*

RECORD

Cased..... in., ..... ft.  
 Sand.....  
 Gas.....  
 Oil.....  
 Total Depth.....

PRODUCTION

1st 24 hrs. Nat.....  
 1st 24 hrs. after shot.....  
 Gas..... Cu. Ft.  
 Dry Hole.....  
 Abandoned.....

Date

8/16/33 192 D. Mannscheck Scout

Map No. 49 Sec. 32 Twp. 19 R. 9W

Well No. 1 - Robinson

Ramsay Company

Contractor

**COMPLETED**

SECTION PLAT

825 Ft. from N. Line

..... Ft. from S. Line

..... Ft. from E. Line

300 Ft. from W. Line


Location.....

Rig up.....

Drilling and Remarks:

RECORD

Cased..... in., ..... ft.

Sand silicious 32 35

Gas.....

Oil.....

Total Depth 3251

PRODUCTION

1st 24 hrs. Nat.....

1st 24 hrs. after shot.....

Gas..... Cu. Ft.

Dry Hole.....

Abandoned.....

pump  
1205 bbls

Date

10-18-33 O. Manschuck