

Rice

Map No. _____ Sec. 32 Twp. 19 R. 9^W


Well No. 1 Robinson Farm _____
Ramsey et al Company _____

_____ Ft. from N. Line

540' Ft. from S. Line

_____ Ft. from E. Line

200' Ft. from W. Line

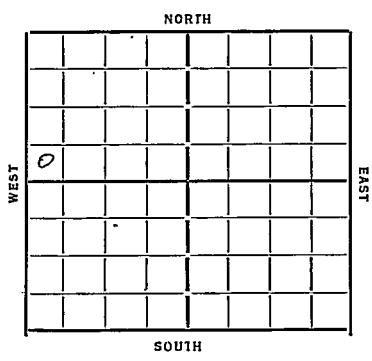

Date 1933

REPORT

4/12	Location
4/19	Cellar
4/26	Bldg Rig
5/4	Rig
5/10	_____
5/17	spud
5/24	20" - 193 - 15" 448 dely 1050'
6/1	By 1755
6/18	10" 1796 8" 2240 HFV 2220 dely 2270'
6/15	dely 2800'
6/21	6" 2888 dely 3110'
6/28	6" 3078 Cony 3213 Siliceous line 3228 show oil 3248 running 5" line
7/5	T.D. 3286 - 1200' - 18 hrs tubing
7/12	pump 3 bbls 24 hrs
7/19	Siliceous 3228 T.D. 3286 treated 660 gallon acid 240 bbls oil
	COMPLETELY

49 **KANSAS** *Rice*
 Map No. _____ Sec. *32* Twp. *19* R. *9* ^W

Well No. *1* *Robinson*
Ramsey et al Company

Contractor

FIRST REPORTS

_____ Ft. from N. Line

540 Ft. from S. Line

_____ Ft. from E. Line

200 Ft. from W. Line

SECTION PLAT

Location _____

Rig up _____

Drilling and Remarks:

RECORD

Cased _____ in., _____ ft.

Sand _____

Gas _____

Oil _____

Total Depth _____

PRODUCTION

1st 24 hrs. Nat. _____

1st 24 hrs. after shot _____

Gas _____ Cu. Ft.

Dry Hole _____

Abandoned _____

Date

APR 12 1933

CHAS. L. SHERWOOD

Scout

Map No. 49 Sec. 37 Twp. 19 R. 9W

Well No. 1- Robinson

Ramsey et al Company

Contractor

SECTION PLAT

.....Ft. from N. Line

540 Ft. from S. Line

.....Ft. from E. Line

200 Ft. from W. Line

COMPLETED

Location.....

RECORD

Cased.....in.,ft.

Sand.....

Gas.....

Oil.....

Total Depth 3286

Drilling and Remarks:

Dilicious 3228

Treated 660 gal as

240 bbls

PRODUCTION

1st 24 hrs. Nat.....

1st 24 hrs. after shot.....

Gas..... Cu. Ft.

Dry Hole.....

Abandoned.....

Date

7/19/33 Orval Marshall Scout