


# KANSAS

Section 32 Township 19 Range 9W

Well No. 2 Wallace

Company Herndon Drlg

Chase  
NORTH

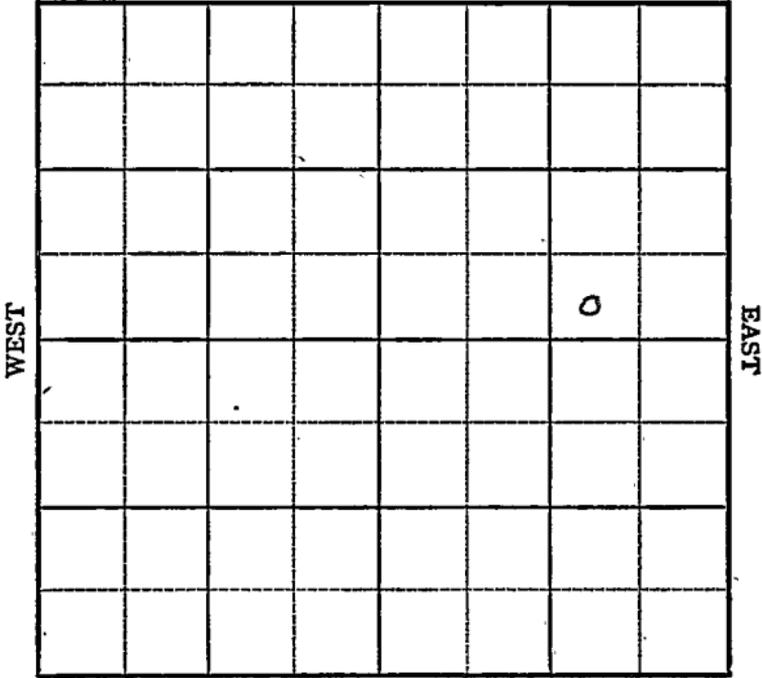

SOUTH

**KANSAS**

Rice

Sec. 32 Twp. 19 R. 9W ✓

Well No. #2 Wallace Farm

Herdon Drlg. Company

Chase Pool


\_\_\_\_\_ Ft. from N. Line

330' Ft. from S. Line

990' Ft. from E. Line

\_\_\_\_\_ Ft. from W. Line

SW SE NE

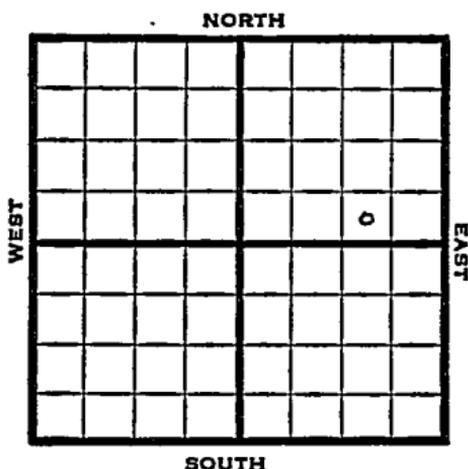

1949 Elev 1710' REPORT

- 2/23 Location
- 3/2 8" @ 231'
- Drlg 2700'
- 3/8 Lansing 3015'
- Arb. 3218-19'
- TD 3219'
- 5" @ 3218'
- 3/16 "
- 3/23 TD 3222'
- 2 bbls oil PH - 500 acid
- 3/30 "
- 4/6 TD 3222'
- Arb. 3218'
- 5" @ 3218'
- 500 acid
- Pump 200 Oil Pot
- 42° Gr.
- Comp

**COMPLETED**

Map No. \_\_\_\_\_ Sec. 32 Twp. 19 R. 9W

Well No. 2 Wallace

Herndon Drlg. Company

FIRST REPORT

Contractor

SW SE NE

SECTION PLAT

\_\_\_\_\_ Ft. from N. Line

330 Ft. from S. Line

990 Ft. from E. Line

\_\_\_\_\_ Ft. from W. Line


Rice County

Location X

Rig up \_\_\_\_\_

Drilling and Remarks: \_\_\_\_\_

RECORD

Cased \_\_\_\_\_ in., \_\_\_\_\_ ft.

Sand \_\_\_\_\_

Gas \_\_\_\_\_

Oil \_\_\_\_\_

Total Depth \_\_\_\_\_

PRODUCTION

1st 24 hrs. Nat. \_\_\_\_\_

1st 24 hrs. after shot \_\_\_\_\_

Gas \_\_\_\_\_ Cu. Ft.

Dry Hole \_\_\_\_\_

Abandoned \_\_\_\_\_

Date

FEB 23 1949 19

S. J. LEWIS Scout

