


RICE

KANSAS

Section 32 Township 19 Range 9W

Well Number 2 Weiland

Company Empire

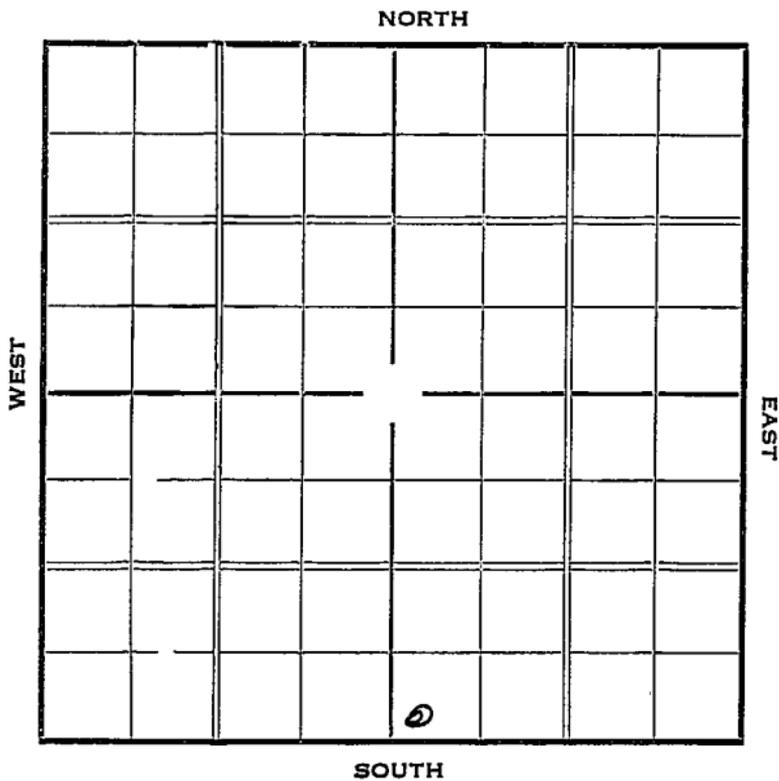

Sec. 32 Twp. 19 R. 9-W

Well No. #2 Weiland Farm

Empire Company


 Ft. from N. Line

250 Ft. from S. Line

 Ft. from E. Line

165 Ft. from W. Line

Elev. 1706

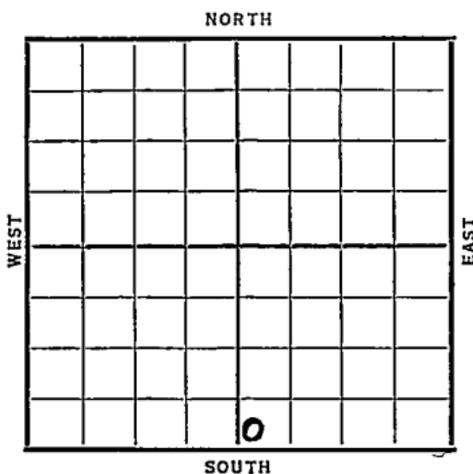

Date	REPORT
1937	
1/13	Rig.
1/21	Spud.
1/28	12" @ 181'. Drlg. 1515'.
2/4	Drlg. 2845
2/11	Sil 3227 Set 7" RUST
2/18	TD 3233'. 2000 acid.
	No test.
2/24	Sil. 3227'.
	T. D. 3233'.
	2000 acid.
	2000 acid.
	Potential 408 bbls. 19 hrs.
	COMPLETED

Map No. 49 Sec. 32 Twp. 19 R. 9W.

Well No. 2 Heiland

Empire Company

Contractor

SECTION PLAT

		o	

_____ Ft. from N. Line

250 Ft. from S. Line

_____ Ft. from E. Line

165 Ft. from W. Line

FIRST REPORT

Location _____

Rig up _____

Drilling and Remarks:

Rig

RECORD

Cased _____ in., _____ ft.

Sand _____

Gas _____

Oil _____

Total Depth _____

PRODUCTION

1st 24 hrs. Nat. _____

1st 24 hrs. after shot _____

Gas _____ Cu. Ft.

Dry Hole _____

Abandoned _____

Date

JAN 13 1937

19

S. J. LEWIS

Scout

Map No. 49 Sec. 32 Twp. 19 R. 9W.

Well No. 2. Keiland

Empire Company

Contractor

SECTION PLAT

_____ Ft. from N. Line

250 Ft. from S. Line

_____ Ft. from E. Line

165 Ft. from W. Line

COMPLETED

Location _____

Rig up _____

Drilling and Remarks:

Sil 3227
2000 acid
2000 acid
Potential
408 ft. 19 hrs.

RECORD

Cased _____ in., _____ ft.

Sand _____

Gas _____

Oil _____

Total Depth 3233

PRODUCTION

1st 24 hrs. Nat. _____

1st 24 hrs. after shot _____

Gas _____ Cu. Ft.

Dry Hole _____

Abandoned _____

Date

FEB 24 1937 19

S. J. LEWIS Scout