

KANSAS

Rice

Section 32 Township 19 Range 9W

Well No. 1 Weiland


Company Pickrell & Ramsey

Chase

NORTH

WEST

EAST

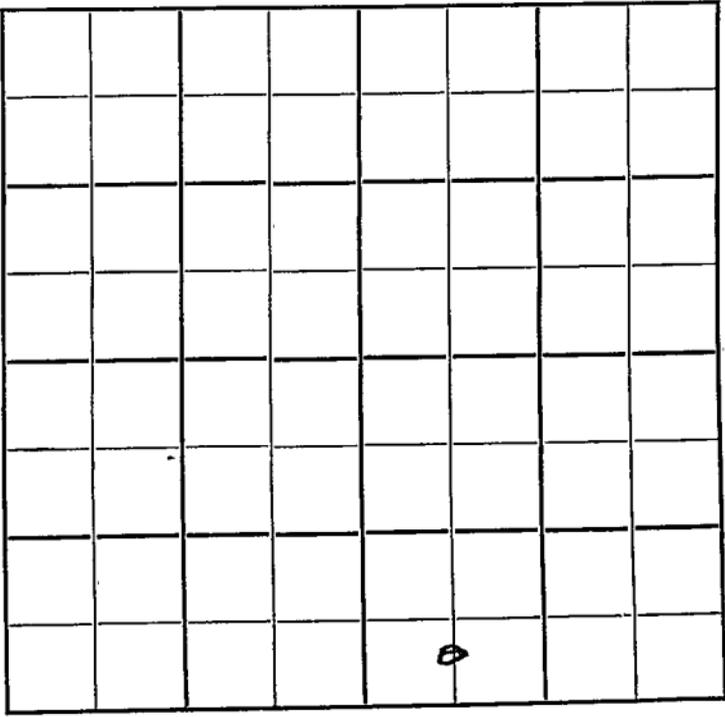

SOUTH

Sec. 32 - Twp. - 19 R. 9W ✓

Well No. #1 Weiland Farm

Pickrell & Ramsey Company

Chase Pool (Pickrell Drlg., Cont.) NORTH


_____ Ft. from N. Line

330' Ft. from S. Line

_____ Ft. from E. Line

660' Ft. from W. Line

C S L SW SE

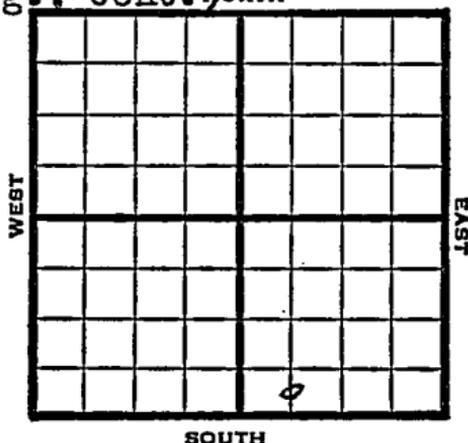

1949 Elev. 1701' REPORT

6/29 All wells plugged
8" @ 208'
Drlg. 2852'

7/6 Arbuckle 3225'
TD 3228'
5" @ 3225'

7/12 "

7/20 Arb. 3225'
5" @ 3225
Abandoned
TD 3233'

ABANDONED

Kansas

Map No. _____ Sec. 32 Twp. 19 R. 9WWell No. 1 WeilandPickrell & Ramsey CompanyPickrell Drlg. Contractor

C S L SW SE

FIRST REPORT
SECTION PLAT

_____ Ft. from N. Line

330 Ft. from S. Line

_____ Ft. from E. Line

660 Ft. from W. Line

Rice County

Location _____

Rig up _____

Drilling and Remarks:

All wells plugged

8" @ 208

drlg. 2852

RECORD

Cased _____ in., _____ ft.

Sand _____

Gas _____

Oil _____

Total Depth _____

PRODUCTION

1st 24 hrs. Nat. _____

1st 24 hrs. after shot _____

Gas _____ Cu. Ft.

Dry Hole _____

Abandoned _____

Date

JUN 29 1949

19

S. J. LEWIS Scout

Kansas

Chase Pool

Map No. R49 Sec. 32 Twp. 19 R. 9W

Well No. 1 Weiland

Pickrell & Ramsey Company

ABANDONED

Contractor

C S L SW SE

E 11701
SECTION PLAT

 Ft. from N. Line

330 Ft. from S. Line

 Ft. from E. Line

660 Ft. from W. Line

Rice County

Location

Rig up

Drilling and Remarks:

Cu x 3225
5" @ 3225

RECORD

Cased in., ft.

Sand

Gas

Oil

Total Depth 3225

PRODUCTION

1st 24 hrs. Nat.

1st 24 hrs. after shot

Gas Cu. Ft.

Dry Hole

Abandoned

Date

JUL 20 1949 19

S. J. LEWIS Scout