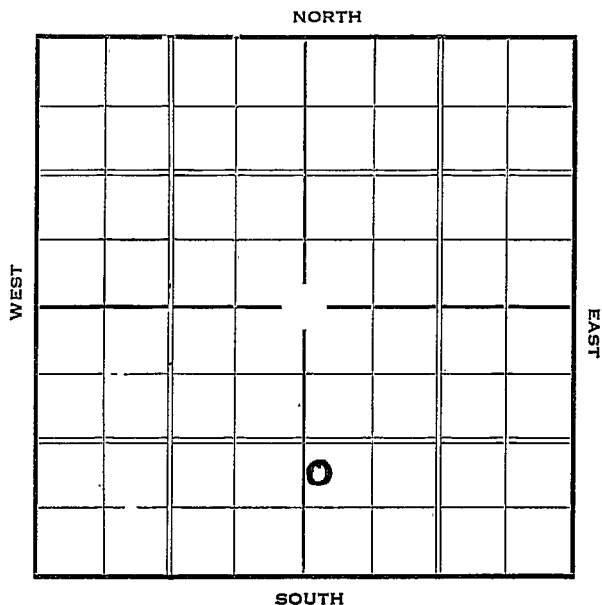


KANSAS

Rice

Section 32 Township 19 Range 9-WWell Number #3 WeilandCompany Empire

Sec. 32 Twp. 19 R. 9-W

Well No. #3 Weiland Farm


Empire Company

Ft. from N. Line

990 Ft. from S. Line

Ft. from E. Line

165 Ft. from W. Line

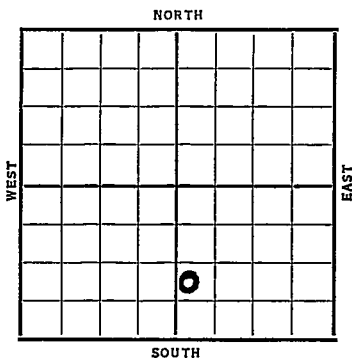[illegible]

Rice KANSASMap No. *49* Sec. *32* Twp. *19* R. *9W*Well No. *3-Weiland**Empire* Company

Contractor

FIRST REPORT

_____ Ft. from N. Line

990 Ft. from S. Line

_____ Ft. from E. Line

165 Ft. from W. Line

SECTION PLAT

		0	

Location _____

Rig up _____

Drilling and Remarks:

B.R.R.

RECORD

Cased _____ in., _____ ft.

Sand _____

Gas _____

Oil _____

Total Depth _____

PRODUCTION

1st 24 hrs. Nat. _____

1st 24 hrs. after shot _____

Gas _____ Cu. Ft.

Dry Hole _____

Abandoned _____

Date

JUN 30 1937 19 H. D. Hatfield Scout

Rice KANSAS

Map No. _____ Sec. 52 Twp. 19 R. 9WWell No. 3 - WeilandEmpire Company

Contractor _____

ABANDONED

SECTION PLAT

		0	

_____ Ft. from N. Line

990 Ft. from S. Line

_____ Ft. from E. Line

165 Ft. from W. Line

Location _____

Rig up _____

Drilling and Remarks:

43' of water in 40
min. by drill stem test

DVA

RECORD

Cased _____ in., _____ ft.

Sand 511 3248

Gas _____

Oil _____

Total Depth 3265

PRODUCTION

1st 24 hrs. Nat. _____

1st 24 hrs. after shot _____

Gas _____ Cu. Ft.

Dry Hole _____

Abandoned _____

Date

JUL 28 1937H. D. Hatfield Scout