


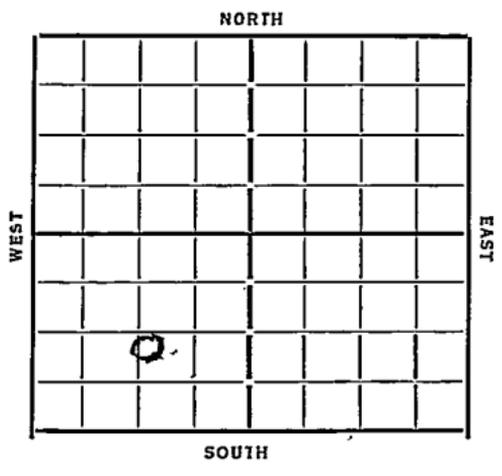

Map No. \_\_\_\_\_ Sec. 32 Twp. 19 R. 9W

Well No. #1 Wilker Farm  
Keith et al Company

\_\_\_\_\_ Ft. from N. Line  
1186 Ft. from S. Line  
\_\_\_\_\_ Ft. from E. Line  
1362 Ft. from W. Line



Date	REPORT
1933	
7/26	Rgn up
8/2	Spud
8/9	20" - 188 - 15" 315 dreg 550'
8/17	15" 315' dreg 1440'
8/23	13" - 1652 dreg 1600'
8/30	dreg 2090'
9/6	10" at 2732 - dreg 2540
9/13	8" at 2810 - show gas 3020 -
9/20	dreg 3028 6" @ vent 3198 P.B.P.
9/29	Top Sil 3255 TD 3281 - 200' oil
10/5	will acidize no test
10/11	acidizing again
10/18	Swab 83 bbls in 12 hrs
10/25	—
11/2	Silicium 3255 TD 3281
	Acidize three times pump 83 bbls
	12 hrs
	COMPLETED


Map No. 49 Sec. 32 Twp. 19 R. 9W

Well No. #1 - Wilke

Keith et al Company

Contractor

SECTION PLAT

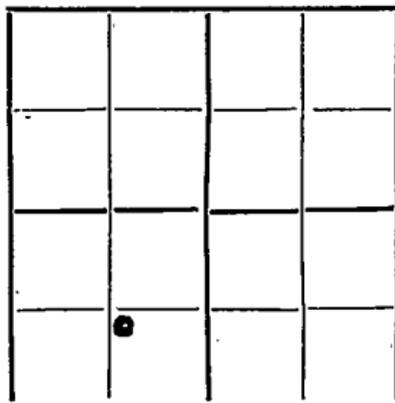

Ft. from N. Line

1186 Ft. from S. Line

Ft. from E. Line

1367 Ft. from W. Line

FIRST REPORT

Location

Rig up

Drilling and Remarks:

Rigs up

RECORD

Cased \_\_\_\_\_ in., \_\_\_\_\_ ft.

Sand \_\_\_\_\_

Gas \_\_\_\_\_

Oil \_\_\_\_\_

Total Depth \_\_\_\_\_

PRODUCTION

1st 24 hrs. Nat. \_\_\_\_\_

1st 24 hrs. after shot \_\_\_\_\_

Gas \_\_\_\_\_ Cu. Ft.


Dry Hole \_\_\_\_\_

Abandoned \_\_\_\_\_

Date

7/26/33 192

O. Manschreck Scout

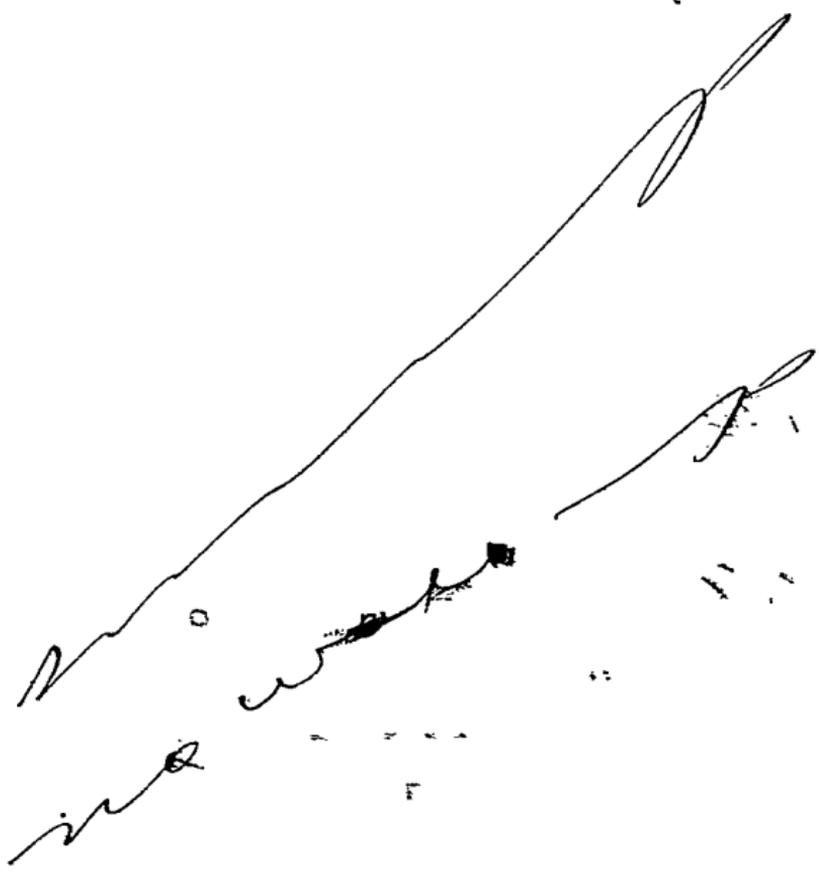

Returned	
Cards	<del>OK</del>
Tracing	<del>OK</del>
France Map	X
Scarborough Map	X
Moody Map	X
Scarborough Plat Book	
Moody Plat Book	

*Rice*  
 Map No. *49* Sec. *32* Twp. *19* R. *9W*  
 Well No. *1-Wilke*  
*Keith et al* Company  
 Contractor

## SECTION PLAT

..... Ft. from N. Line  
*1186* Ft. from S. Line  
 ..... Ft. from E. Line  
*1362* Ft. from W. Line

	0		<del>*</del>

**COMPLETED**

Location.....

Rig up.....

Drilling and Remarks:

*acidized  
 three times*

*Pump 83 bbls  
 12 hrs*

## RECORD

Cased *3* in., *325* ft.  
 Sand *siliceous 325*  
 Gas.....  
 Oil.....  
 Total Depth *3281*

## PRODUCTION

1st 24 hrs. Nat.....  
 1st 24 hrs. after shot.....  
 Gas..... Cu. Ft.  
 Dry Hole.....  
 Abandoned.....

Date

*11-1-33* 192 *O. Mansuech* Scout

*see over*

CHECK :-  
WE SHOW IN ~~SW~~ SW  
QUARTER.

Sam

You mean SW.  
Dw

Returned	
Cards	<i>MPB</i>
Tracing	<i>MPB</i>
France Map	<i>X</i>
Scarborough Map	<i>X</i>
Moody Map	<i>X</i>
Scarborough Plat Book	
Moody Plat Book	

*no wall*  
*no wall*