


Section 32 Township 19 Range 1W

Well No. 1 Day

Company Kornfield et al
Ritz-Canton Pool

NORTH

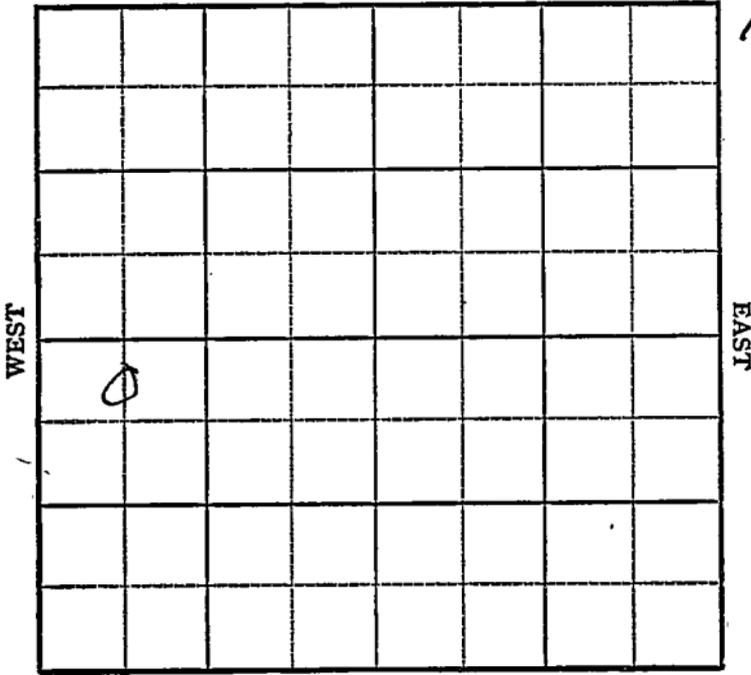

12

WEST

EAST

SOUTH

Sec. 32 Twp. 19 R. 1W

Well No. 1 Day Farm

Kornfield et al Company

Ritz-Canton Pool


330 Ft. from N. Line

_____ Ft. from S. Line

_____ Ft. from E. Line

660 Ft. from W. Line

C N L N^W SW

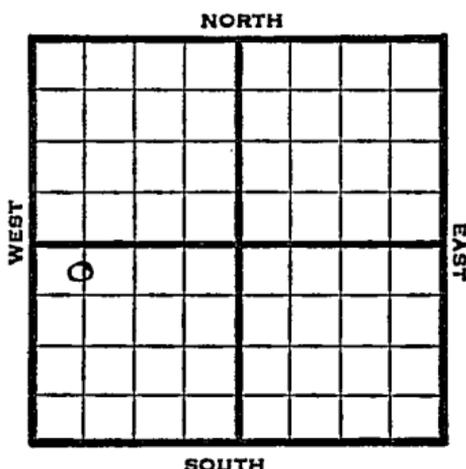

1948 Elev. 1582' REPORT

9/1 Well Abandoned Location

9/8 8" @ 142'
Dr lg 2720'

9/14 Miss 2939'
Viola 3430'-31'
TD 3431'
5" @ 3430'

9/21 TD 3436' SSO

9/29 TD 3438 SO&W
PB 3283'
7 shots 2981-87'
SO&W

10/6 "

10/13 Viola 3430'
TD 3438'

ABANDONED

McPherson County Kansas State

Map No. _____ Sec. 32 Twp. 19 R. 1W

Well No. 1 Day

Kornfield etal. Company

FIRST REPORT

Contractor

C N L NW SW

SECTION PLAT

330 Ft. from N. Line

_____ Ft. from S. Line

_____ Ft. from E. Line

660 Ft. from W. Line


Ritz-Canton Pool

Remarks:

Well abandoned Location

Date
SEP 1 1948

Scout S. J. LEWIS

 


- Misc. Small Maps _____
- Cards *Darlene* _____
- Tracing *[scribble]* _____
- France Map *[scribble]* _____
- Scarborough Map *[scribble]* _____
- Pierce Map *[scribble]* _____
- Geological Dept. _____
- Pierce Plat Book _____

Kansas

Ritz-Canton

Map No. 43 Sec. 32 Twp. 19 R. 1WWell No. 1 DayKornfield et al. Company**ABANDONED**

Contractor

C N L NW SW

E11582
SECTION PLAT330 Ft. from N. Line Ft. from S. Line Ft. from E. Line660 Ft. from W. Line

o			

McPherson County

Location Rig up

Drilling and Remarks:

Violator 3430

RECORD

Cased in. ft.Sand Gas Oil Total Depth 3430

PRODUCTION

1st 24 hrs. Nat. 1st 24 hrs. after shot Gas Cu. Ft.Dry Hole Abandoned

Date

OCT 13 1948 19S. J. LEWIS

Scout

Misc. Small Maps	
Cards	
Printing	
Frame Map	
Searborough Map	
Pierce Map	
Geological Dept.	
Pierce Flat Book	