

Section 32 Township 19 Range 1WWell No. #1 LacquementCompany United Drlg.

NORTH

2

				0			

SOUTH

WEST

EAST

CONTRACTOR United Drlg.

Ritz-Canton Pool

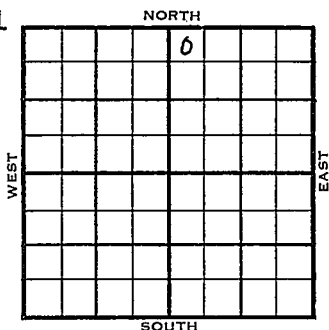
330 Ft. from N. Line

____ Ft. from S. Line

Ft. from E. Line

330 _____ Ft. from W. Line

NW NW NE



ELEVATION

REPORT

1951.

1577'

4/7 Surface set.

5/5 | 8" @ 160'

Miss 2945', V 3437'

RTD 3439⁰

5" @ 3438'

5/12 DD 3441 RFW

PB 3025

16/2982-86, 250A

P/5 BO + 1 BWPH

5/19 Spud 4-22-54 Oil well TD 3441

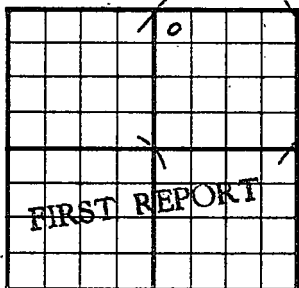
8" @ 160 Miss 2945 Viola 3437

TD 3439 5" @ 3438 DD 3441 HFW

PB 3025 16/2982-86 250 A

P/5 BO 1 BWPH Comp. 150 BOPD 30 BW

COMPLETED

County **McPherson** State **Kansas**Sec. **32** (Blk. Twp.) **19** (Sur. Rge.) **1W** Map No.Operator **United Drlg.**Well No. **1** Farm **Iacquetent**Elev. Location **NW NW NE**
330 Ft. From **N** Line **NE**
330 Ft. From **W** Line Quarter
1st. Report **APR 7 1954**

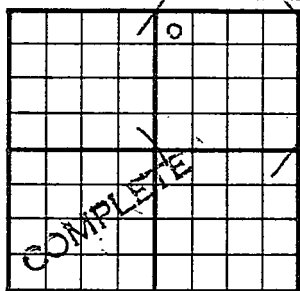
Completion

Remarks

Spudding Date

Drlg. Data

Ritz-Canton Pool**surface set****J. G. McGEHEE**

County McPherson State KansasSec. 32 (Blk.
Twp.) 19 (Sur.
Rge.) 1W Map No.Operator United Drlg.Well No. 1 Farm LacuenentElev. 1577 Location NW NW NE330 Ft. From N Line NE330 Ft. From W Line Quarter

1st. Report

Completion MAY 1 9 1954Remarks Ritz-Canton PoolSpudding Date 4-22-54Drlg. Data Oil well TD 34418" @ 160 Miss. 2945 Viola 3437TD 3439 5" @ 3438 DD 3441 HFWPB 3025 16/ 2982-86 250 A P/ 5 bo1 bwph Comp. 150 bopd 30 bw