


Rice

Form 51-5M-11-31-Palace

Map No. KANSAS Sec. 32 Twp. 19 R. 9th

Well No. School lot Ramsey et al Farm Company

NORTH

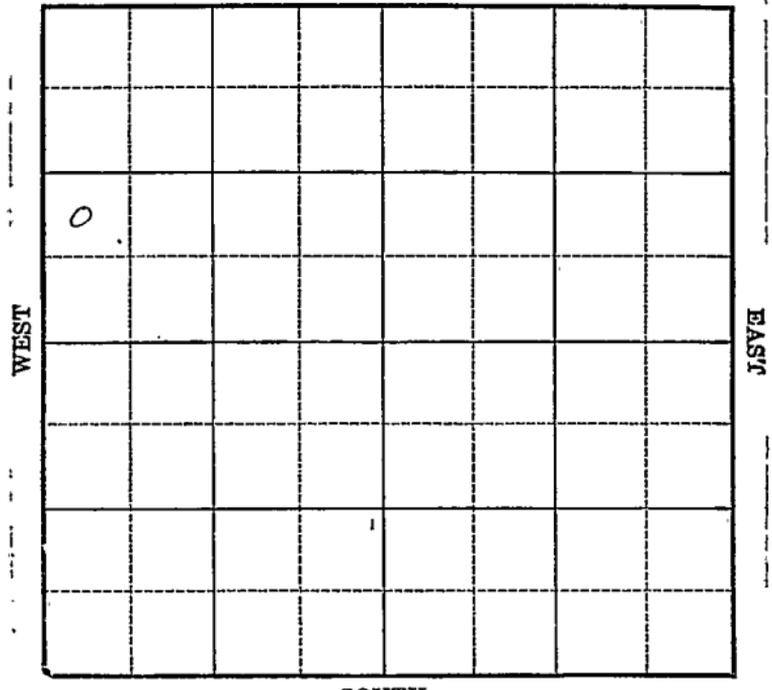

SOUTH

Location _____

Drilling Remarks _____

Rig Up _____

Drilling Remarks _____

RECORD

Cased _____ in. _____ ft.

Sand _____

Gas _____

Oil _____

Total Depth _____

PRODUCTION

1st 24 hrs. Nat. _____

1st 24 hrs. after shot _____

Gas _____ cu. ft.

Dry Hole _____

Abandoned _____

Rice

Map No. KANSAS Sec. 32 Twp. 19 R. 9w

Well No. 1 - School lot Farm


Ramsey et al Company

1627 Ft. from N. Line

_____ Ft. from S. Line

_____ Ft. from E. Line

307 Ft. from W. Line

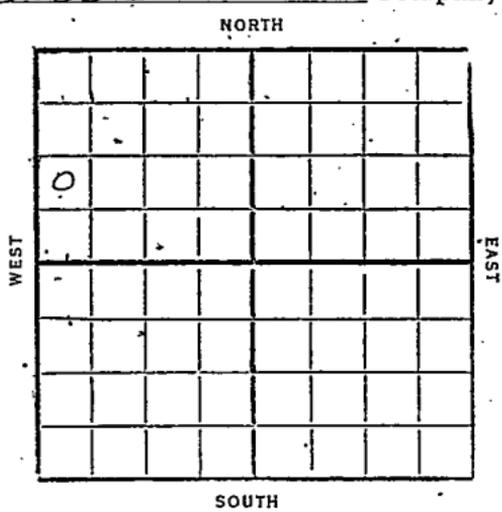

1932

Date	REPORT
	<u>1</u>
<u>9/30</u>	<u>2 p.d.g.</u>
<u>10/5</u>	<u>20"-185</u>
	<u>15"-429</u>
	<u>Dreg 725'</u>
<u>10/12</u>	<u>" 7265'</u>
<u>10/19</u>	<u>10"-2000</u>
	<u>dreg 2080'</u>
<u>10/26</u>	<u>10"-2005</u>
	<u>SD 2190'</u>
<u>11/2</u>	<u>TD 2195' 2 1/2" 10"</u>
<u>11/9</u>	<u>SD 2600'</u>
<u>11/16</u>	<u>dreg 2690'</u>
<u>11/23</u>	<u>dreg 8 1/4"-2900'</u>
<u>11/30</u>	<u>dreg about 3000'</u>
	<u>(Refuse to give information)</u>
<u>12/7</u>	<u>Top Silic lime 3250 3237</u>
	<u>TD 3278</u>
	<u>1800 ft oil in hole</u>
	<u>To swab</u>
<u>12/14</u>	<u>Top Silic lime 3245 3237</u>
	<u>TD 3267</u>
	<u>swab 13 bbl per hr for 12 hrs</u>
	<u>show water</u>

12/21- TD 3285

swab 173 bbl 12 hr

Then shot 120 qt

swab 15 bbl per hour
for 12 hrs.

sw by 300 ft off bottom

12/28- Top Cong. 3220

" Silic lime 3237

6" 3237

First oil 3245'

1 barrel water 3285-89

TD. 3289

P.B. 3284

swab 9 bbl per hr natural

shot 120 qt

swab 14 bbl per hr

1933

Top Cong 3220'

1/4-

Cased 6" 3237

Silic lime 3237-89

First oil 3245

1 barrel water 3285-89

TD. 3289

P.B. 3284

shot 120 qt

swab 14 bbl per hour

Comp.

Rice

49 KANSAS

W

Map No. Sec. 32 Twp. 19 R. 9

Well No. 1 School Lot

Ramsay et al Company

Contractor

FIRST REPORTS

SECTION PLAT

o			

1677 Ft. from N. Line

..... Ft. from S. Line

..... Ft. from E. Line

307 Ft. from W. Line

Lot 10 Blk 44

Chase township

Location

Rig up

Drilling and Remarks:

Apdz

RECORD

Cased in., , ft.

Sand

Gas

Oil

Total Depth

PRODUCTION

1st 24 hrs. Nat.

1st 24 hrs. after shot

Gas Cu. Ft.

Dry Hole

Abandoned

Date

SEP 30 1932

CHAS. L. SHERWOOD

192

Scout

Returned *[Handwritten mark]*
Cards *[Handwritten mark]*
Tracing *[Handwritten mark]*
France Map *[Handwritten mark]*
Scarborough Map *[Handwritten mark]*
Moody Map *[Handwritten mark]*
Scarborough Plat Book
Moody Plat Book

Rice

W

Map No. **KANSAS** Sec. 32 Twp. 19 R. 9

Well No. School Lot

Ramsey Co Company

Contractor

COMPLETE

SECTION PLAT

1647 Ft. from N. Line
 _____ Ft. from S. Line
 _____ Ft. from E. Line
307 Ft. from W. Line

o			

Location _____

Rig up _____

Drilling and Remarks:

Top on 3280
1st Oil 3245
1 BW 3285-89
PB 3284
Shot 120 gr
Swab 14 bls per hour

RECORD

Cased 6 in., 3237 ft.
 Sand 5/11 3237-3289
 Gas _____
 Oil _____
 Total Depth 3289

PRODUCTION

1st 24 hrs. Nat. _____
 1st 24 hrs. after shot _____
 Gas _____ Cu. Ft.
 Dry Hole _____
 Abandoned _____

Date

JAN 4 1933

192 CHAS. L. SHERWOOD Scout

*no more
no more
map*

Returned	<i>[Signature]</i>
Cards	<i>[Signature]</i>
Tracing	<i>[Signature]</i>
France Map	<i>X</i>
Scarborough Map	<i>X</i>
Moody Map	<i>X</i>
Scarborough Plat Book	<i>X</i>
Moody Plat Book	