


Section 32 Township 19 Range 12 W

Well No. # 1 Steckel

Company G-M-R Oil

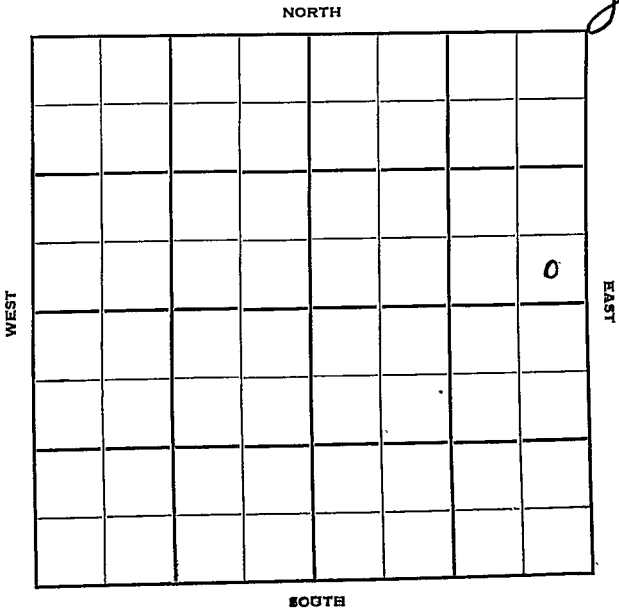

Barton

KANSAS

Sec. 32 Twp. 19 R. 12W ✓

Well No. #1 SteckeI Farm

G M R Oil Company

Contractor

Ft. Zarah Pool

Ft. from N. Line

330


Ft. from S. Line

330

Ft. from E. Line

Ft. from W. Line

SE SE NE

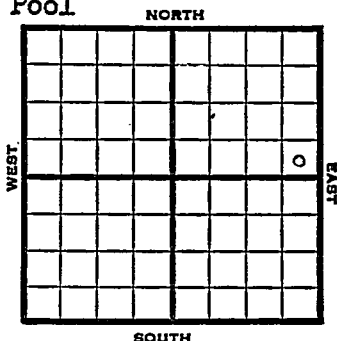

1951 Elev. 1816' REPORT

10/3
12/5

Location
 Spud -
 Oil Well TD 3386
 8" @ 150
 Br Li 3102 KC 3172
 Cong. 3358 Arb. 3367
 5" @ 3369 TD 3379 1000 A
 S/ 21 BO 13 hr. DD 3386
 2000 A S/ 51 BO
 Comp. 157 BOPD 35 % wtr.

COMPLETED

County Barton State Kansas

Sec. 32 (Blk. Twp.) 19 (Sur. Rge.) 12W Map No.

Operator G-N-R Oil

Well No. 1 Farm Steckel

Elev. _____ Location SE SE NE

FIRST REPORT				0

330 Ft. From S Line NE

330 Ft. From E Line Quarter

Ist. Report OCT 3 1951

Completion _____

Remarks _____

Spudding Date _____

Drlg. Data _____ Ft. Zarah Pool

Location _____

J. E. TYRA

