
FORM. 51 25M 8-50 WESTERN Barton KANSAS

Section 32 Township 19 Range 12W

Well No. 2 Johnson

Company G-M-R Oil

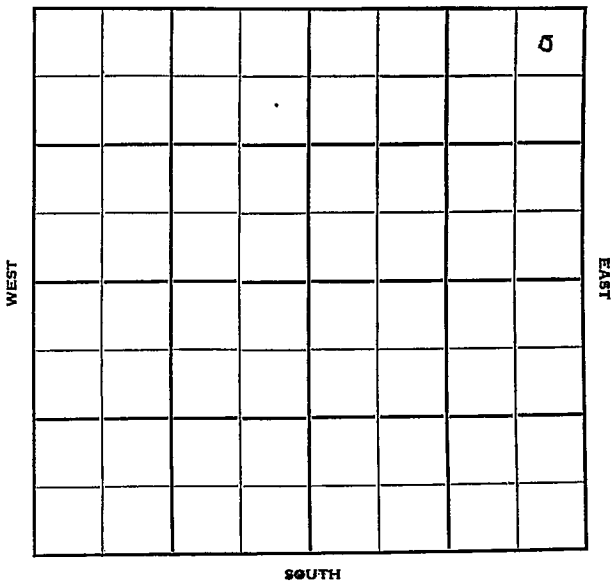

FORM 252-B
10M 11-50 PETROL

Barton KANSAS

Sec. 32 Twp. 19 R. 12W

Well No. #2 Johnson Farm

G-M-R Oil Company

G-M-R - Contr. Contractor

Fort Zarah Pool


330' Ft. from N. Line

Ft. from S. Line

330' Ft. from E. Line

Ft. from W. Line

NE NE NE

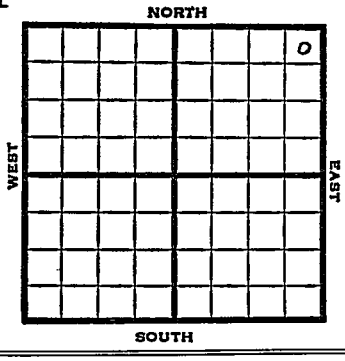

1951	Elev. 1818' REPORT
8/1	Spud 7-26-51 8" @ 175 Anhy 614 Drlg. 2650
8/29	Spud 7-26-51 Oil well TD 3384' 8" @ 175 Anhy 614' Heeb 2984' Br. lime 3102 Lans. 3118' Cong 3363' Arb. 3379' TD 3384' 5" @ 3381 CO to 3384 1 BOPH DD 3385' 1000 A S/ 6-8 BOPH P/18 BOPH Comp. 418 BOPD COMPLETED

FORM 275 FOR SALE BY KANSAS BLUE PRINT CO.


County Barton State Kansas

Sec. 32 (Blk. Twp.) 19 (Sur. Rge.) 12W Map No.

Operator G-M-R Oil

Well No. 2 Farm Johnson

Elev. Location NE NE NE

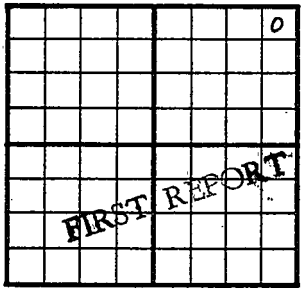

330 Ft. From N Line NE

330 Ft. From E Line Quarter

1st. Report AUG 1 1951

Completion

Remarks

G-M-R - Contr.

Spudding Date 7-26-51

Drlg. Data Fort Zarah Pool

8" @ 175 Anhy 614 drlg. 2650

J. E. TYRA

FORM 275 FOR SALE BY KANSAS BLUE PRINT CO.


County Barton State Kansas

Sec. 32 (Blk. Twp.) 19 (Sur. Rge.) 12W Map No.

Operator G-M-R Oil

Well No. 2 Farm Johnson

Elev. 1818 Location NE NE NE

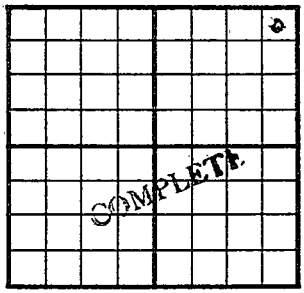

330 Ft. From N Line NE

330 Ft. From E Line Quarter

1st. Report

Completion AUG 2 9 1951

Remarks Fort Zarah Pool

G-M-R Oil & Contr.

Spudding Date 7-26-51

Drlg. Data Oil well TD 3384

8" @ 175 Anhy 614 Heeb. 2984

Br. lime 3102 Lans. 3118 Cong. 3363

Arb. 3379 TD 3384 5" @ 3381 CO to 3384

1 boph DD 3385 1000 A S/6-8 boph

P/ 18 boph Comp. 418 bopd

J. E. TYRA