
FORM 51 25M 8-50 WESTERN Barton KANSAS

Section 32 Township 19 Range 12W

Well No. 2 Stark

Company G-M-R Oil

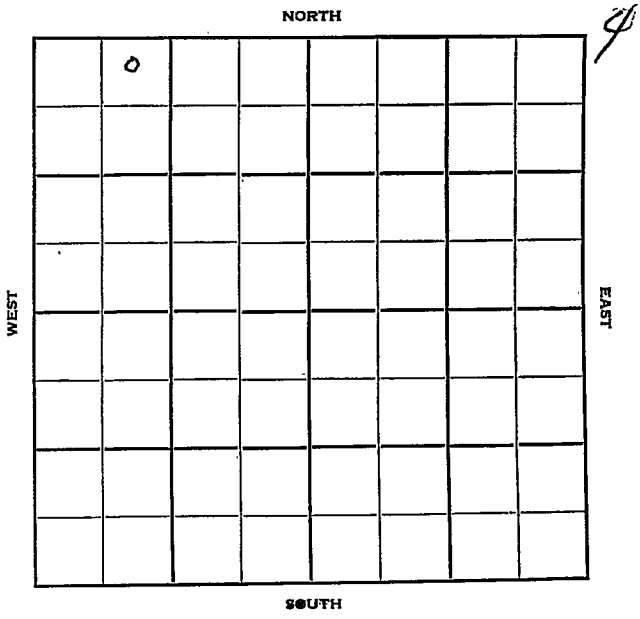

FORM 252-B
10M 11-50 PETROL

Barton

KANSAS

Sec. 32 Twp. 19 R. 12 W

Well No. # 2 Stark Farm

G-M-R Oil Company

G-M-R Contractor


330 Ft. from N. Line

Ft. from S. Line

Ft. from E. Line

1025 Ft. from W. Line

NE NW NW

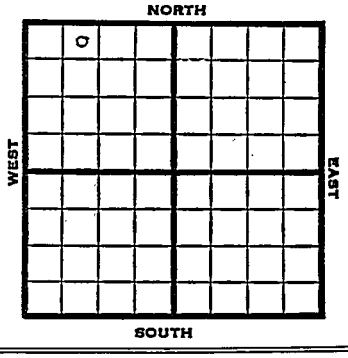

1951	Elev. 1819' REPORT
7/18	MIR
8/29	Spud 7-17-51 Oil well TD 3396' 8" @ 185 Anhy 614' Heeb 2982' Br. lime 3101 Lans. 3116' DST 3117-42 open ½ hr. rec 185' GCM DST 3144-87 open 45 min. rec 15' O & GCM Cong. 3357' Arb. 3388' TD 3396' 5" @ 3391 CO to 3396 4 BOPH 1000 A S/25 BOPH 4 hr. P/17 BOPH Comp. 476 BOPD COMPLETED

FORM 275 FOR SALE BY KANSAS BLUE PRINT CO.


County Barton State Kansas

Sec. 32 (Blk. Twp.) 19 (Sur. Rge.) 12W Map No.

Operator G-M-R Oil

Well No. 2 Farm Stark

Elev. Location NE NW NW

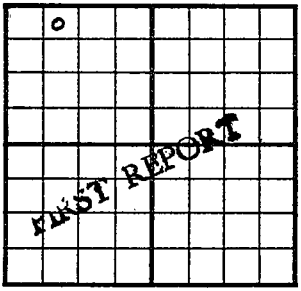

330 Ft. From N Line NW

1025 Ft. From W Line Quarter

1st. Report JUL 18 1951

Completion

Remarks

G-M-R - Contr.

Spudding Date

Drlg. Data

M I R

J. E. TYRA

FORM 275 FOR SALE BY KANSAS BLUE PRINT CO.


County Barton State Kansas

Sec. 32 (Blk. Twp.) 19 (Sur. Rge.) 12W Map No.

Operator G-M-R Oil

Well No. 2 Farm Stark

Elev. 1819 Location NE NW NW

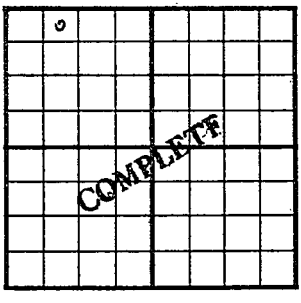

330 Ft. From N Line NW

1025 Ft. From W Line Quarter

1st. Report

Completion AUG 2 9 1951

Remarks

G-M-R Oil - Contr.

Spudding Date 7-17-51

Drlg. Data Oil well TD 3396

8" @ 185 Anhy 614 Heeb. 2982

Br. lime 3101 Lans. 3116 DST 3117-42

open ½ hr. Rec. 185' gcm DST 3144-87

open 45 min. Rec. 15' o & gcm Cong. 3357

Arb. 3388 TD 3396 5" @ 3391 CO to 3396

4 boph 1000 A S/ 25 boph 4 hr.

P/ 17 boph Comp. 476 bopd

E. TYRA