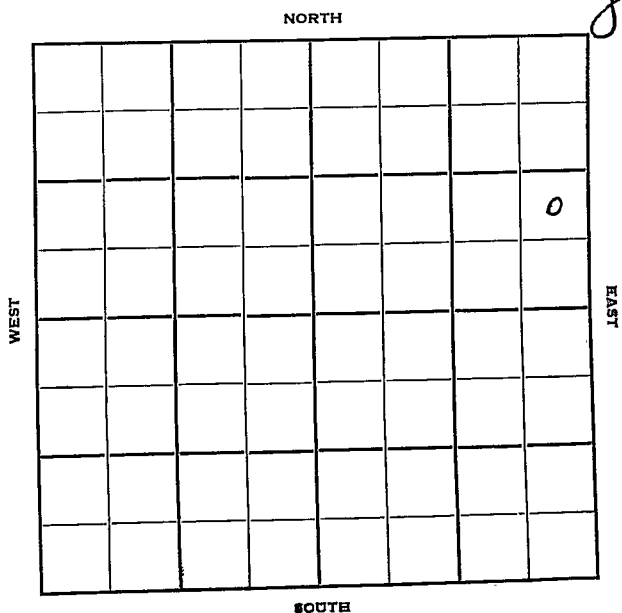


Section 32 Township 19 Range 12 WWell No. # 3 D. C. JohnsonCompany G-M-R Oil

Barton

KANSAS

Sec. 32 Twp. 19 R. 12W


Well No. #3 D. C. Johnson Farm

G M R Oil Company

Contractor

Ft. Zarah Pool

NORTH

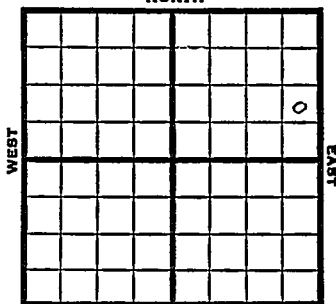

Ft. from N. Line

990

Ft. from S. Line

330

Ft. from E. Line

Ft. from W. Line

NE SE NE

SOUTH

1951

Elev. 1817' REPORT

10/3

Location

1952

1/2

Spud 11-4-51
Oil Well TD 3391
8" @ 168
Heeb. 2982
Br Lime 3100
Lans. 3116
Cong. 3355
Arb. 3386-91
5" @ 3387
CO to 3391
250 A
S/9 boph Comp. 401 bopd

COMPLETED

County Barton State Kansas
 Sec. 32 (Blk. Twp.) 19 (Sur. Rge.) 12W Map No.
 Operator G-M-R Oil
 Well No. 3 Farm D. C. Johnson
 Elev. _____ Location NE SE NE

FIRST REPORT									

990 Ft. From S Line NE
330 Ft. From E Line Quarter
 1st. Report OCT 3 1951

Completion _____

Remarks _____

Spudding Date _____

Drlg. Data _____

Ft. Zarah Pool

Location

J. E. TYRA

J. E. TYRA