


Section 32 Township 19 Range 12W

Well No. #1 Johnson

Company G M R Oil

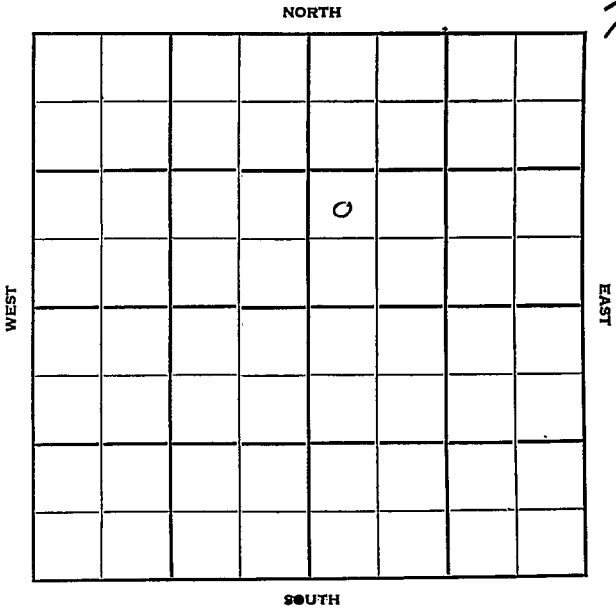



Sec. 32 Twp. 19 R. 12 W

Well No. # 4 Johnson Farm

G-M-R Oil Company

Greeley Drlg. Contractor


Ft. from N. Line

990 Ft. from S. Line

Ft. from E. Line

330 Ft. from W. Line

NW SW NE

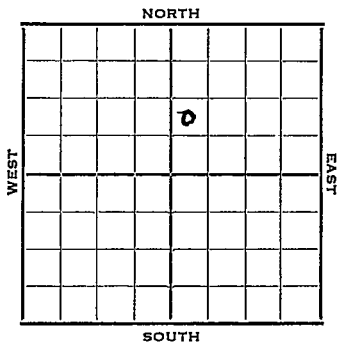

1952 Elev. 1816' REPORT

7/23 MIR
7/30 8" @ 132'
Drlg. 2275'
8/6 Heeb. 2984 Br Li 3097
Lans 3114 Cong 3352
Arb. 3377
TD 3385' 5" @ 3379'
8/13 DP 3385' S/1 Boph 3000 A
S/12 Boph for 2 hrs. POP
8/20 NR
8/27 Spud 7-22-52 Oil Well TD 3385
8" @ 132' Heeb. 2984 Br Li 3097
Lans. 3114 Cong. 3352
Arb. 3377
TD 3385 5" @ 3379 DP to 3385
S/ 1 boph 3000 A S/ 12 boph
Comp. 158 bopd

COMPLETED

County Barton State Kansas

Sec. 32 (Blk. Twp.) 19 (Sur. Rge.) 12W Map No.

Operator G-M-R Oil

Well No. 4 Farm Johnson

Elev. _____ Location NW SW NE

		0			

990 Ft. From S Line NE

330 Ft. From W Line Quarter

1st. Report JUL 23 1952

Completion _____

Remarks _____

Greeley Drlg. - Contr.

Spudding Date _____

Drlg. Data _____

M I R

