

G.W.O.


Barton

KANSAS

Section 32 Township 19 Range 12 W

Well No. # 4 Stark

Company G-M-R Oil

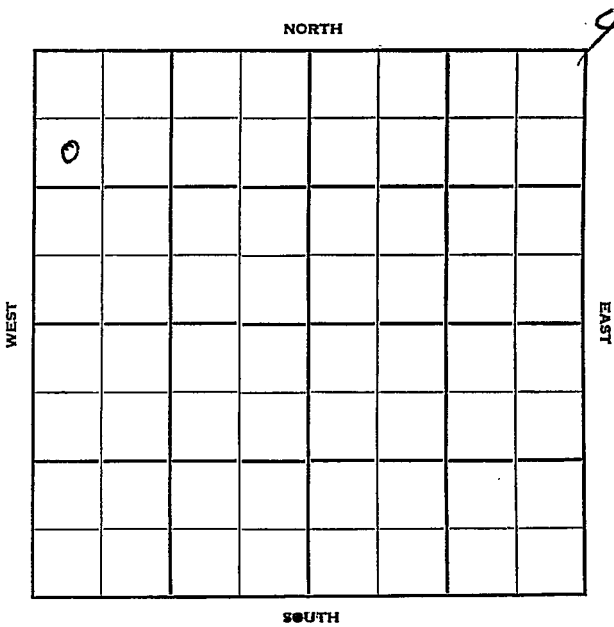

Barton

O.W.W.O.

KANSAS

Sec. 32 Twp. 19 R. 12W

Well No. #4 Stark Farm

G M R Oil Company

G M R Contractor


990 Ft. from N. Line

_____ Ft. from S. Line

_____ Ft. from E. Line

330 Ft. from W. Line

SW NW NW

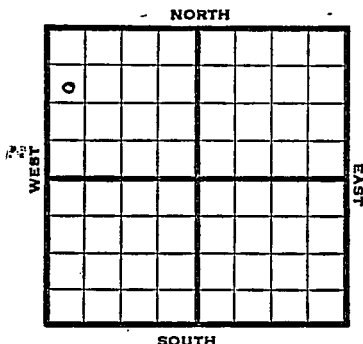

1952 Elev. 1819' REPORT

2/20 Spud 2-18-52
8" @ 170' WOC

3/5 DD to 3400 S/20 BOPH Nat Testing

3/11 1000 A S/ 30 BOPH POP

3/19 POP

3/25 "

4/1 "

4/9 "

4/16 Spud 2-18-52
Oil Well TD 3400
8" @ 170
Anhy 610-34 Br Li 3098
KC 3115 Arb. 3387-92
5" @ 3389 DD 3400 S/ 20 boph
1000 A S/ 30 boph
Comp. 288 bopd 25% wtr.

COMPLETED

1952
8/13 Lans. 3115' Arb. 3387-prod. O.W.W.O.
5" @ 3389' OTD 3400'
To test KC

8/20 PB 3330' 16/3246-54 2000 A
F/30 BOPH for 2 hrs.

OVER

1952

8/27

Oil Well TD 3400
Lans. 3115 Arb. 3387
5" @ 3389 OTD 3400 PB 3330
16/ 3246-54 2000 A F/ 30 boph
Comp. 837 bopd

COMPLETED

County **Barton** State **Kansas**

Sec. **32** (Blk. Twp.) **19** (Sur. Rge.) **12W** Map No.

Operator **G-M-R oil**

Well No. **4** Farm **Stark**

Elev. Location **SW NW NW**

0					

990 Ft. From **N** Line **NW**

330 Ft. From **W** Line **Quarter**

1st. Report **FEB 20 1952**

Completion

Remarks

G-M-R - Contr.

Spudding Date **2-18-52**

Drlg. Data

8" @ 170 WOC

J. G. McGEHEE

County Barton State Kansas

Sec. 32 (Blk. 19) (Sur. Rge.) 12W Map No.

Operator G-M-R Oil

Well No. 4 Farm Stark

Elev. 1819 Location SW NW NW

0					

COMPLETE

990 Ft. From N Line NW

330 Ft. From W Line Quarter

1st. Report

Completion APR 16 1952

Remarks

G-M-R Oil - Contr.

Spudding Date 2-18-52

Drlg. Data Oil well TD 3400

8" @ 170 Anhy 610-34 Br. lime 3098

KC 3115 Arb. 3387-92 5" @ 3389

DD 3400 S/ 20 boph 1000 A S/ 30 boph

Comp. 288 bopd 25% water

County **Barton** State **Kansas**

Sec. **32** (Blk. Twp.) **19** (Sur. Rge.) **12W** Map No.

Operator **G - M - R Drlg.**

Well No. **4** Farm **Stark**

Elev. **1819** Location **SW NW NW**

0					

990 Ft. From **N** Line **NW**

330 Ft. From **W** Line Quarter

1st. Report **AUG 13 1952**

Completion

Remarks **OWTO**

Spudding Date

FIRST REPORT

O.W.W.O.
O.W.W.O.

Drlg. Data

Lans 3115 Arb 3387-prod. 5" @ 3389 OTD 3400 to test KC

J. G. McGEHEE

County Barton State Kansas

Sec. 32 (Blk. 19 (Twp.) (Sur. 12W (Rge.) Map No.

Operator G-M-R Drlg.

Well No. 4 Farm Stark

Elev. 1819 Location SW NW NW

o							

990 Ft. From N Line NW

330 Ft. From W Line Quarter

Ist. Report

Completion AUG 27 1952

Remarks OWWO

Spudding Date O.W.W.O

Drlg. Data Oil well TD 3400

Mans. 3115 Arb. 3387 5" @ 3389

OTD 3400 PB 3330 16/ 3246-54 2000 A

F/ 30 boph Comp. 837 bopd