
FORM 51 25M 3-49 PETROL Barton KANSAS

Section 32 Township 19 Range 12 W

Well No. # 5 Stark

Company G-M-R Oil

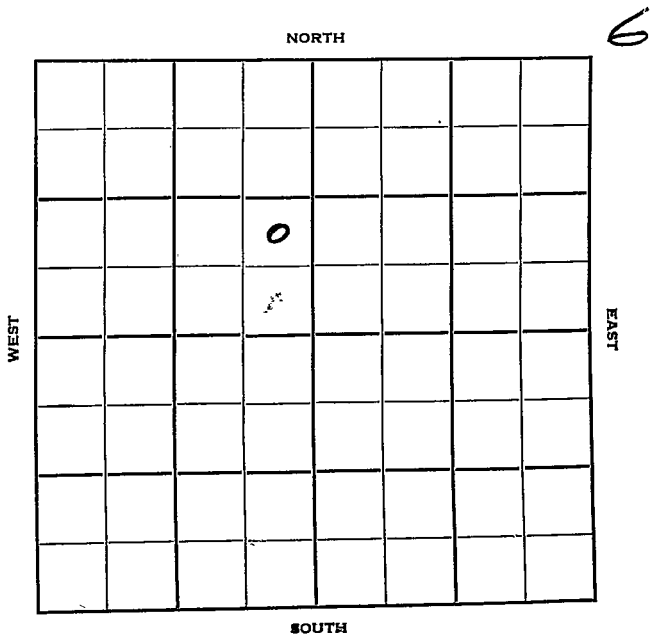

FORM 252-B
10M 8-51 TPCO.

Barton KANSAS

Sec. 32 Twp. 19 R. 12W

Well No. #5 Stark Farm

G-M-R Oil Company

Greeley Drlg.- Contr. Contractor


Ft. from N. Line

990' Ft. from S. Line

330' Ft. from E. Line

Ft. from W. Line

NE SE ~~SW~~ NW

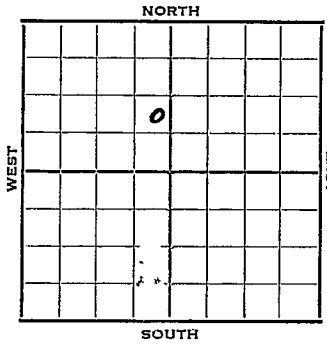

1952	Elev. 1817' REPORT
4/23	Spud 4-16-52 8" @ 137 Drlg. 2690'
4/30	Br Li 3103 Lans. 3118 DST 3125-92, 1 hr. 30' OCM DST 3225-94' 1 hr. rec. 10' m Arb. 3382-87 5" @ 3387'
5/7	WOCT
5/14	DP CO 3397 S/3 BOPH 250 A S/7 BOPH POP
5/21	NR
5/28	Spud 4-16-52 Oil Well TD 3387' 8" @ 137' Br Li 3103 Lans. 3118 DST 3125-92 open 1 hr. rec. 30' OCM DST 3225-94 open 1 hr. rec. 10' mud Arb. 3382-87 5" @ 3387 CO to 3387 S/ 3 boph 250 A S/ 7 boph Comp. 217 bopd

COMPLETED

FORM 275 FOR SALE BY KANSAS BLUE PRINT CO.


County Barton State Kansas

Sec. 32 (Blk. Twp.) 19 (Sur. Rge.) 12W Map No.

Operator G-M-R Oil

Well No. 5 Farm Stark

Elev. 1817 Location NE SE SW

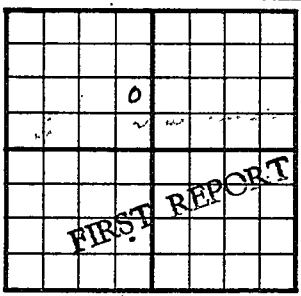

990 Ft. From S Line (NW)

330 Ft. From E Line Quarter

1st. Report APR 23 1952

Completion

Remarks Greeley Drlg. - Contr.

Spudding Date 4-16-52

Drlg. Data

8" @ 137 drlg. 2690

J. G. McGEHEE

FORM 275 FOR SALE BY KANSAS BLUE PRINT CO.


County Barton State Kansas

Sec. 32 (Blk. Twp.) 19 (Sur. Rge.) 12W Map No.

Operator G-M-R oil

Well No. 5 Farm Stark

Elev. 1817 Location NE SE NW

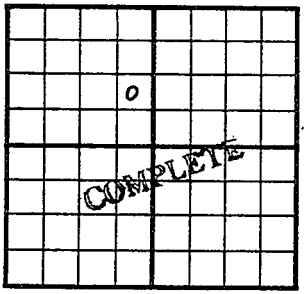

990 Ft. From S Line NW

330 Ft. From E Line Quarter

1st. Report

Completion MAY 28 1952

Remarks

Greeley Drlg. - Contr.

Spudding Date 4-16-52

Drlg. Data Oil well TD 3387

8" @ 137 Br. lime 3103 Lans. 3118

DST 3125-92 open 1 hr. Rec. 30' ocm

DST 3225-94 open 1 hr. Rec. 10' mud

Arb. 3382-87 5" @ 3387 CO to 3387

S/ 3 boph 250 A S/ 7 boph

Comp. 217 bopd

J. G. McGEHEE