


FORM 51 Barton

KANSAS

Section 32 Township 19 Range 12W

Well No. 6 Starke

Company G-M-R Oil

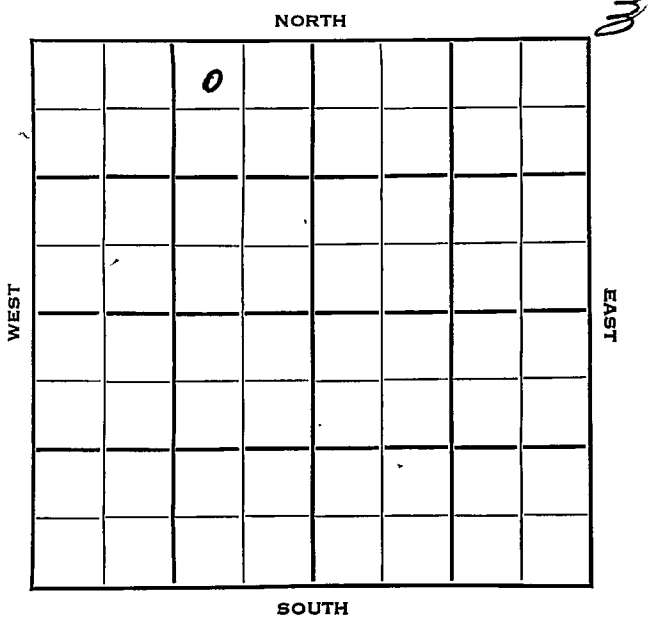

Barton

KANSAS ✓

Sec. 32 Twp. 19 R. 12W

Well No. #6 Starke Farm

G-M- R Oil Company

Contractor


330 Ft. from N. Line

_____ Ft. from S. Line

990 Ft. from E. Line

_____ Ft. from W. Line

NW NE NW

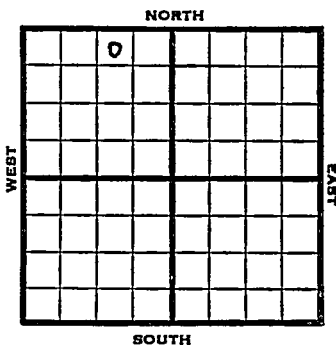

1952 Elev. 1819' REPORT

11/26 Location

12/4 8" @ 164'

12/11 Br 1. 3097 KC 3112 DST 3333-62 3/4 Hr.
20' oil 70' muddy oil Arb 3372-80 RTD
5" @ 3376

12/18 CO 3380 S/1 1/2 BOPH 250A No Help 750A
No Help DD 3386 TD S/2 1/2 BOPH 500A
S/4 BOPH Tub & Rods

12/25 " " "

1953

1/7 Spud 11-30-52
OilWell
TD 3386'
8" @ 164
Br lime 3097, KC 3112
DST 3333-62, opn 3/4 hrs., rec.
20' oil, 70' muddy oil
Arb. 3372
TD 3380
5" @ 3376
CO to 3380
S/1 1/2 boph 250A 750A
DD 3386 S/2 1/2 boph 500A
S/4 boph
Comp. 200 bopd

COMPLETED

County **Barton** State **Kansas**

Sec. **32** (Blk. Twp.) **19** (Sur. Rge.) **12W** Map No.

Operator **G-M-R Oil**

Well No. **6** Farm **Starke**

Elev. Location **NW NE NW**

330 Ft. From **N** Line **NW**

990 Ft. From **E** Line **Quarter**

Ist. Report **NOV 26 1952**

Completion

Remarks

Spudding Date

FIRST REPORT

Drlg. Data

Location

J. G. McGEHEE

County Barton State Kansas

Sec. 32 (Blk. 19 (Sur. 12W (Twp.) 12W Map No.

Operator G-M-R Oil

Well No. 6 Farm Starke

Elev. 1819 Location NW NE NW

		o				

330 Ft. From N Line NW

990 Ft. From E Line Quarter.

Ist. Report

Completion JAN 7 1953

Remarks

Spudding Date 11-30-52

Drlg. Data Oil well TD 3386

8" @ 164 Br. lime 3097 KC 3112

DST 3333-62 open 3/4 hr. Rec. 20' oil

70' muddy oil Arb. 3372 TD 3380

5" @ 3376 CO to 3380 S/ 1/2 boph 250 A

750 A DD 3386 S/ 2 1/2 boph 500 A

S/ 4 boph Comp. 200 bopd