

SIDE ONE

STATE CORPORATION COMMISSION OF KANSAS
OIL & GAS CONSERVATION DIVISION

WELL COMPLETION OR RECOMPLETION FORM
ACO-1 WELL HISTORY

DESCRIPTION OF WELL AND LEASE

Operator: License # 5238
Name Petroleum, Inc.
Address P. O. Box 1255
City/State/Zip Liberal, KS 67901

Purchaser NA

Operator Contact Person Steve Phillips
Phone 316-624-1686

Contractor: License # 5382
Name Cheyenne Drilling

Wellsite Geologist Charles Moore, Jr.
Phone 713-363-9813

Designate Type of Completion
 New Well Re-Entry Workover
 Oil SWD Temp Abd
 Gas Inj Delayed Comp.
 Dry Other (Core, Water Supply etc.)

If OWWO: old well info as follows:
Operator
Well Name
Comp. Date
Old Total Depth

WELL HISTORY

Drilling Method:
 Mud Rotary Air Rotary Cable

10/23/85 11/6/85
Spud Date Date Reached TD Completion Date
4800 3530
Total Depth PBTD

Amount of Surface Pipe Set and Cemented at 415 feet
Multiple Stage Cementing Collar Used? Yes No
If yes, show depth set 2805 feet
If alternate 2 completion, cement circulated
from 2805 feet depth to surf. w/ 140 SX cmt

API NO. 15-171-20,308

County Scott

SW NE Sec. 35 Twp. 19S Rge. 33 East West

3300 Ft North from Southeast Corner of Section
1980 Ft West from Southeast Corner of Section
(Note: Locate well in section plat below)


Lease Name Smith "B1" Well # 1

Field Name Hugoton North

Producing Formation

Elevation: Ground 2947 KB 2956

Section Plat

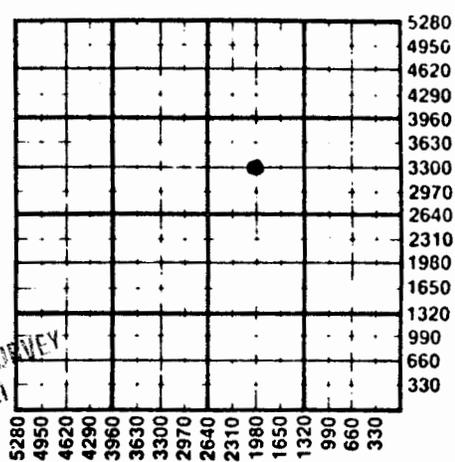

APR 30 1986
GEOLOGICAL SURVEY
WICHITA FALLS

WATER SUPPLY INFORMATION

Disposition of Produced Water: Disposal Repressuring
Docket #

Questions on this portion of the ACO-1 call:
Water Resources Board (913) 296-3717

Source of Water:
Division of Water Resources Permit #

Groundwater.....Ft North from Southeast Corner
(Well)Ft West from Southeast Corner of
Sec Twp Rge East West

Surface Water.....Ft North from Southeast Corner
(Stream, pond etc).....Ft West from Southeast Corner
Sec Twp Rge East West

Other (explain) The Hub of Syracuse
(purchased from city, R.W.D. #)

INSTRUCTIONS: This form shall be completed in duplicate and filed with the Kansas Corporation Commission, 200 Colorado Derby Building, Wichita, Kansas 67202, within 90 days after completion or recompletion of any well. Rule 82-3-130 and 82-3-107 apply.

Information on side two of this form will be held confidential for a period of 12 months if requested in writing and submitted with the form. See rule 82-3-107 for confidentiality in excess of 12 months.

One copy of all wireline logs and drillers time log shall be attached with this form. Submit CP-4 form with all plugged wells. Submit CP-111 form with all temporarily abandoned wells.

SIDE TWO

Operator Name Petroleum Inc Lease Name Smith "B1" Well # 1

Sec 35 Twp 19S Rge 33 East West County Scott

WELL LOG

INSTRUCTIONS: Show important tops and base of formations penetrated. Detail all cores. Report all drill stem tests giving interval tested, time tool open and closed, flowing and shut-in pressures, whether shut-in pressure reached static level, hydrostatic pressures, bottom hole temperature, fluid recovery, and flow rates if gas to surface during test. Attach extra sheet if more space is needed. Attach copy of log.

Drill Stem Tests Taken	<input checked="" type="checkbox"/> Yes	<input type="checkbox"/> No	Formation Description <input checked="" type="checkbox"/> Log <input type="checkbox"/> Sample
Samples Sent to Geological Survey	<input checked="" type="checkbox"/> Yes	<input type="checkbox"/> No	
Cores Taken	<input type="checkbox"/> Yes	<input checked="" type="checkbox"/> No	

DST #1 2603-67 30-60-60-120			
IHP - 1311	FHP - 1300		
IFP - 99-99	FFP - 110-110		
ISI - 308	FSI - 308		
Rec'd 120' gassy drlg. mud			
DST #2 3775-3805 30-60-60-120			
IHP - 1994	FHP - 1983		
IFP - 176-485	FFP - 572-822		
ISI - 1017	FSI - 1017	BHT - 118°	
Rec'd 1750' salty sulfur water			
DST #3 4085-4113' Misrun			
DST #4 4369-4411 30-60-60-120			
IHP - 2123	FHP - 2112		
IFP - 77-77	FFP - 110-110		
ISI - 1148	FSI - 1137	BHT - 120°	
Rec'd 120' thin mud			

Name	Top	Bottom
Cimmarron Anhyd.	2451	+505
Krider	2621	+335
Council Grove	2865	+ 91
Topeka	3549	-593
Heebner	3814	-848
Toronto	3825	-869
Lansing	3858	-902
Base K.C.	4265	-1309
Marmaton	4285	-1329
Cherokee	4408	-1452
Morrow Shale	4552	-1596
U. Morrow Sd	4560	-1604
L. Morrow Sd	4592	-1636
Mississippi-St.Lou	4653	-1697
TD	4800	-1844

(see attached sheet)

<p align="center">CASING RECORD <input checked="" type="checkbox"/> New <input type="checkbox"/> Used</p> <p align="center">Report all strings set-conductor, surface, intermediate, production, etc.</p>							
Purpose of String	Size Hole Drilled	Size Casing Set (in O.D.)	Weight Lbs/Ft.	Setting Depth	Type of Cement	#Sacks Used	Type and Percent Additives
Surface	12 1/4	8 5/8	24	415	C	250	2% cc
Production	7 7/8	5 1/2	14 & 15.5	4230	50/50 Poz	140	10% salt 4%
DV Tool		Second stage			HLC	300	
<p align="center">PERFORATION RECORD</p>				<p align="center">Acid, Fracture, Shot, Cement Squeeze Record</p>			
Shots Per Foot	Specify Footage of Each Interval Perforated			(Amount and Kind of Material Used)		Depth	
4	2627-31			1000 gals. 15% Hydrochloric acid		2627-31	
				500 gal. gelled pad & 2130 gal w/1#/gal. 12/20 sand		2627-31	
<p>TUBING RECORD</p>							
Size	Set At	Packer at	Liner Run	<input type="checkbox"/> Yes <input type="checkbox"/> No			
Date of First Production	Producing Method						
	<input type="checkbox"/> Flowing <input type="checkbox"/> Pumping <input type="checkbox"/> Gas Lift <input type="checkbox"/> Other (explain)						

Halad 322

35-19-33W

Smith "BL" #1
Sec. 35-19S-33W
Scott Cty., KS

API No. 15-171-20,308

DST #5 4448-85 30-60-60-120
IHP - 2177 FHP - 2166
IFP - 55-55 FFP - 55-55
ISI - 110 FSI - 110 BHT - 120°
Rec'd 1' vsocm

DST #6 4556-75 30-60-60-120
IHP - 2238 FHP - 2238
IFP - 81-48 FFP - 81-65
ISI - 323 FSI - 403 BHT - 125°
Rec'd 20' mud

DST #7 4554-4615 30-60-60-120
IHP - 2286 FHP - 2286
IFP - 97-81 FFP - 113-97
ISI - 645 FSI - 484 BHT - 127°
Rec'd 90' socm

DST #8 4066-4153 Misrun

DST #9 4066-4153 Misrun

APR 30 1986

RECEIVED
SURVEY
BRANCH

RECEIVED
STATE CORPORATION COMMISSION

APR 23 1986

CONSERVATION DIVISION
Wichita, Kansas