Barton


DX 78-1

KANSAS

Section 33 Township 19 Range 11W

Well No. #2 Schartz "D"

Company C.E. Ash

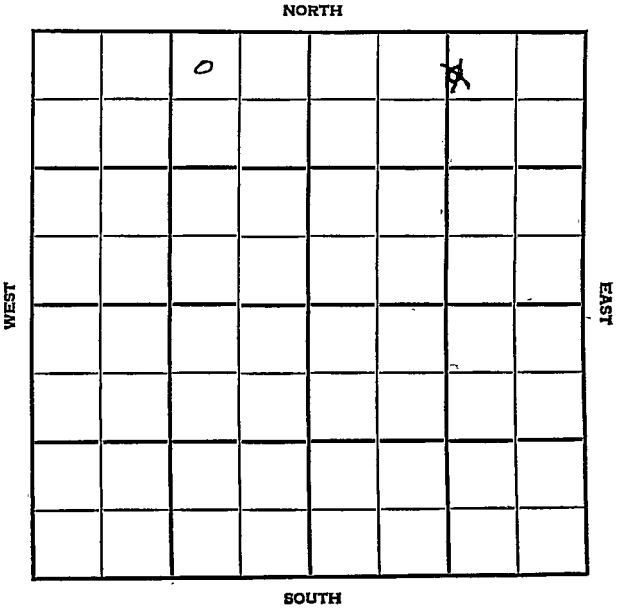

Barton KANSAS

SEC.	TWP.	R.
33	19	11W

WELL NO. #2 Schartz "D" FARM

COMPANY C.E. Ash

CONTRACTOR Bea Tools.

Chase-Silica Pool


330 Ft. from N. Line

Ft. from S. Line

1200 Ft. from E. Line

Ft. from W. Line

NW NE ~~NE~~ NW

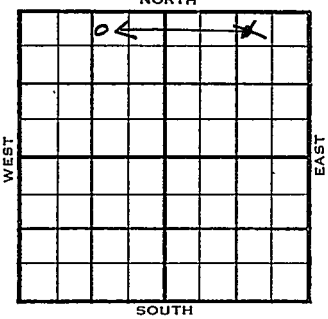

1954	ELEVATION 1783' DF REPORT
9/22	Spud 9-16-54 8" @ 207' Anhy 550' Drlg. 2200'
10/20	Spud 9-16-54 Oil Well TD 3337' 8" @ 207' Anhy 550', Top 2659', Heeb 2918', Tor 2937', B. Oread. 2949', Br. Lime 3038', Lans 3059' DST 3061'-91' opn 1 hr, rec gas in 12 min, rec 2400' oil, 985# DST 3107'-37' opn 1 hr, gas in 15 min rec 120' O & GCM, 360' free oil 475# Arb. 3318' TD 3321' 5" @ 3319' DD 3337' S/ 2 boph 1000 A S/ 8 boph Comp 200 bopd. COMPLETED

DX-78

FORM 275 FOR SALE BY KANSAS BLUE PRINT CO.


County Barton State Kansas

Sec. 33 (Blk. Twp.) 19 (Sur. Rge.) 11W Map No.

Operator C. E. Ash

Well No. 2 Farm Schartz "D"

Elev. 1783 DF Location NW NE NE

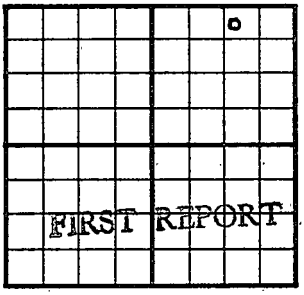

330 Ft. From N Line NE

1200 Ft. From E Line Quarter

1st. Report SEP 2 2 1954

Completion

Remarks

Bea Tools

Spudding Date 9/16/54

Drlg. Data Chase-Silica Pool

8" @ 207, Anh 550, Drlg 2200

FABEN GILSTRAP

FORM 26 200 BKS, 4-52 PETROL

Map No. _____ Sec. 33 Twp. 19 R. 11W

Well No. 2 Schartz "D"

C. E. Ash Company

CORRECTION Contractor

NW NE NW

330 Ft. from N. Line


_____ Ft. from S. Line

1200 Ft. from E. Line

_____ Ft. from W. Line

Barton Co.

SECTION PLAT

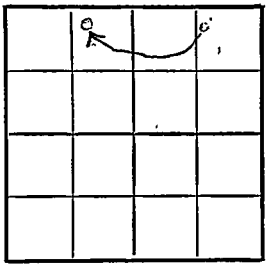

Location _____

Rig up _____

Drilling and Remarks:

Reported

NW NE NE

RECORD

Cased _____ in., _____ ft.

Sand _____

Gas _____

Oil _____

Total Depth _____

PRODUCTION

1st 24 hrs. Nat. _____

1st 24 hrs. after shot _____

Gas _____ Cu. Ft.

Dry Hole _____

Abandoned _____

Date

SEP 29 1954 19 FABEN GILSTRAP Scout

FORM 275 FOR SALE BY KANSAS BLUE PRINT CO.


County Barton State Kansas

Sec. 33 (Blk. Twp.) 19 (Sur. Rge.) 11W Map No.

Operator C. E. Ash

Well No. 2 Farm Schartz "D"

Elev. 1783 Location NW NE NW

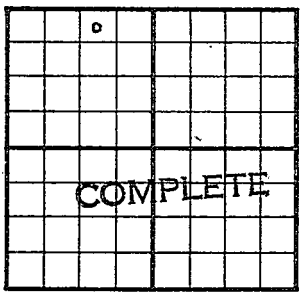

330 Ft. From N Line NW

1200 Ft. From E Line Quarter

1st. Report

Completion OCT 20 1954

Remarks Chase-Silica Pool

Bea - Contr.

Spudding Date 9-16-54

Drlg. Data Oil well TD 3337

8" @ 207 Anhy 550 Top. 2659

Heeb. 2918 Tor. 2937 B. Oread 2949

Br. lime 3038 Lans. 3059 DST 3061-91

open 1 hr. gas in 12 min. Rec. 2400' oil

985# DST 3107-37 open 1 hr. gas in

15 min. Rec. 120' o & gcm 360' free oil

475# Arb. 3318 TD 3321 5" @ 3319

DD 3337 S/ 2 boph 1000 A S/ 8 boph

Comp. 200 bopd

FABEN GILSTRAP