
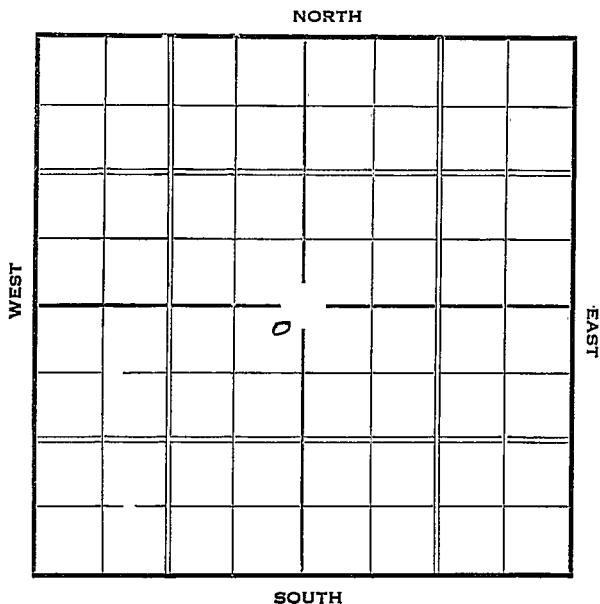


Section 33 Township 19 Range 11WWell Number 2 BurmeisterCompany Stanolind

Sec. 33 Twp. 19 R. 11-WWell No. #2 Burmeister Farm
Stanolind Company330 Ft. from N. Line Ft. from S. Line330 Ft. from E. Line Ft. from W. Line

Elev. 1773

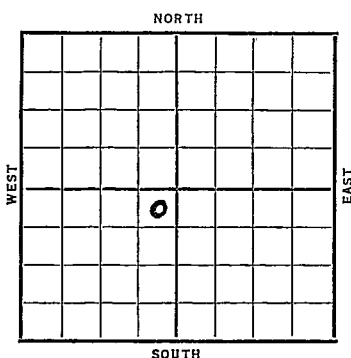

Date	REPORT
1/57	
1/60	Location
1/14	Building rig.
1/21	Surface hole.
1/28	13" @ 199'. Drllg. 2295'.
2/4	KCL 3075 Coring 3320
2/11	Conglomerate 3315' Sil 3324', 7" @ 3325 T.D. 3332 WOC
2/18	TD 3342'. $\frac{1}{2}$ bailer oil per hour.
2/26	1000 acid 1 bbl oil per hr. 2000 acid. No test
3/4	Shut Down
3/11	Coring 3355'.
3/18	Shut Down 3355'.
3/24	Sil. 3324'. T. D. 3363'. 3000 acid. Water.
	ABANDONED

KANSAS

Map No. 46 Sec. 33 Twp. 19 R. 11W

Well No. 2 Burnmeister

Standard Company

Contractor

SECTION PLAT

380 Ft. from N. Line

_____ Ft. from S. Line

330 Ft. from E. Line

_____ Ft. from W. Line

FIRST REPORT

Location ✓

Rig up _____

Drilling and Remarks:

*There is d.kc.
There No 1 is in
NE 1/4 35-19-11W
07*

RECORD

Cased _____ in., _____ ft.

Sand _____

Gas _____

Oil _____

Total Depth _____

PRODUCTION

1st 24 hrs. Nat. _____

1st 24 hrs. after shot _____

Gas _____ Cu. Ft.

Dry Hole _____

Abandoned _____

Date

JAN 6 1937 19

S. J. LEWIS Scout

KANSAS *Boston*Map No. *46* Sec. *33* Twp. *19* R. *11W*Well No. *2. Burmeister**Standard* Company

Contractor

SECTION PLAT

	2		

320 Ft. from N. Line

Ft. from S. Line

320 Ft. from E. Line*11* Ft. from W. Line

ABANDONED

Location

Rig up

Drilling and Remarks:

Oil 3324
3000 acid
water

RECORD

Cased _____ in., _____ ft.

Sand _____

Gas _____

Oil _____

Total Depth *3363*

PRODUCTION

1st 24 hrs. Nat. _____

1st 24 hrs. after shot _____

Gas _____ Cu. Ft.

Dry Hole ☒Abandoned ☒

Date

19

S. J. LEWIS Scout