


Section 33 Township 19 Range 11W

Well No. 1 Thomas

Company Graybol & Smith

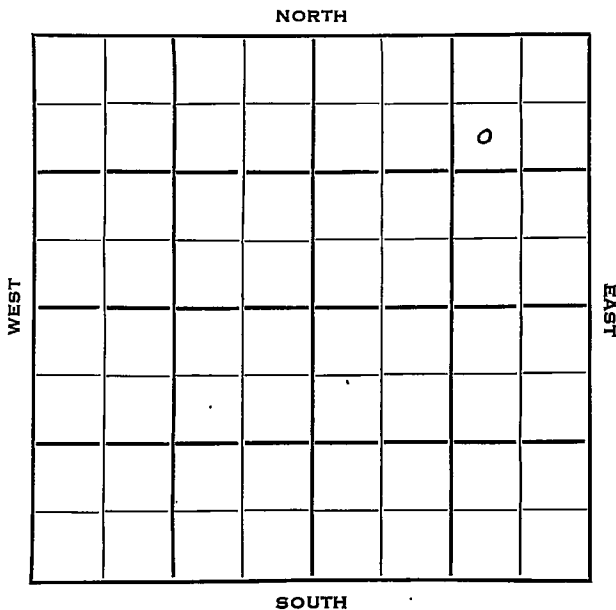

Bartch

Sec. 33 Twp. 19 R. 11W

Well No. 1 Thomas Farm

Graybol & Smith Company


Contractor

990 Ft. from N. Line

_____ Ft. from S. Line

990 Ft. from E. Line

_____ Ft. from W. Line

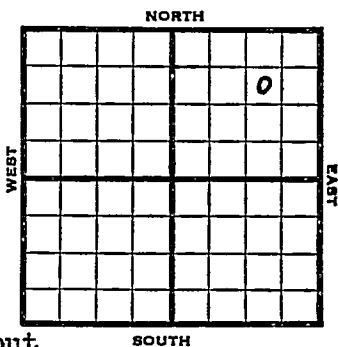

SW NE NE
Stanolind farmout

1953 Elev. 1781' REPORT

4/1

Cellar & Pits

4/9

8" @ 197 Anhy 550'

Drlg. 2550'

4/15

Spud 4-1-53

D&A

TD 3389

8" @ 197

Anhy 550, Top 2668, Heeb 2935, Tor 2955, Br lime 3054, Fans 3074, Arb. 3335

DST 3214-26, opn 20 mins., rec. 5' mud, 0#

TD 3389

D&A

ABANDONED

County Barton State KansasSec. 33 (Blk. Twp.) 19 (Sur. Rge.) 11W Map No.Operator Graybol & SmithWell No. 1 Farm ThomasElev. Location SW NE NE

990 Ft. From N Line NE990 Ft. From E Line Quarter1st. Report APR 1 1953

Completion

Remarks Stanolind farmout

Spudding Date

Drlg. Data

Cellar & pits

