


Section 33 Township 19 Range 10-W

Well Number #1-Hathaway

Company Shell

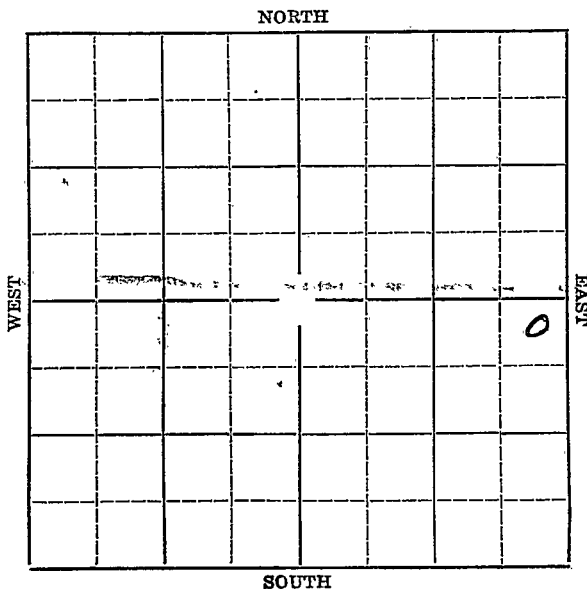

Sec. 33 Twp. 19 R. 10W

Well No. #1 Hathway Farm

Shell Company


NORTH

364' Ft. from N. Line

_____ Ft. from S. Line

330' Ft. from E. Line

_____ Ft. from W. Line

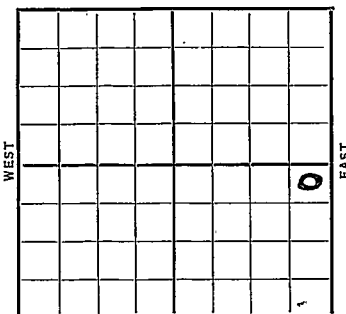

Elev. 1779

~~1936~~

REPORT

9/23 13" @ 223'. Waiting on cmt.

10/1 Drlg. 1639'.

10/8 Drlg. 2850'.

10/15 No report.

10/22 Sil. 3334'. 7" @ 3336'. Hole f
full of water. 3353' TD. SD.

10/29 Fishing bailer.

11/6 P. B. 3352 1000 acid

Shot 10 qts.

11/12 Shot 119 shots Lane gun. 3314-33

$\frac{1}{4}$ bbl. oil. P. B. ~~3334~~³³³⁴.

11/18 Sil. 3334 T. D. 3353

P. B. 3334' 1000 acid.

Pot. 15 bbls.

COMPLETED

KANSAS

Map No. 55 Sec. 33 Twp. 19 R. 15WWell No. 1 HathewayShell Company

Contractor

SECTION PLAT

			o

364 Ft. from N. Line

_____ Ft. from S. Line

330 Ft. from E. Line

_____ Ft. from W. Line

FIRST REPORT

Location _____

Rig up _____

Drilling and Remarks:

13" @ 223 WOC

RECORD

Cased _____ in., _____ ft.

Sand _____

Gas _____

Oil _____

Total Depth _____

PRODUCTION

1st 24 hrs. Nat. _____

1st 24 hrs. after shot _____

Gas _____ Cu. Ft.

Dry Hole _____

Abandoned _____

Date

SEP 23 1936

19

S. J. LEWIS

Scout

KANSAS

Form 26-1M Bks.-2-29

Map No. 46 Sec. 33 Twp. 19 R. 10W

Well No. 1 Hathaway

Shell Company

Contractor

SECTION PLAT

			0

364 Ft. from N. Line

_____ Ft. from S. Line

330 Ft. from E. Line

_____ Ft. from W. Line

COMPLETED

Location _____

Rig up _____

Drilling and Remarks:

Sil 2334

P.B. 334

1000 acid

27 15 7/16

RECORD

Cased _____ in., _____ ft.

Sand _____

Gas _____

Oil _____

Total Depth 3353

PRODUCTION

1st 24 hrs. Nat. _____

1st 24 hrs. after shot _____

Gas _____ Cu. Ft.

Dry Hole _____

Abandoned _____

Date

NOV 19 1936 19

S. J. LEWIS Scout