
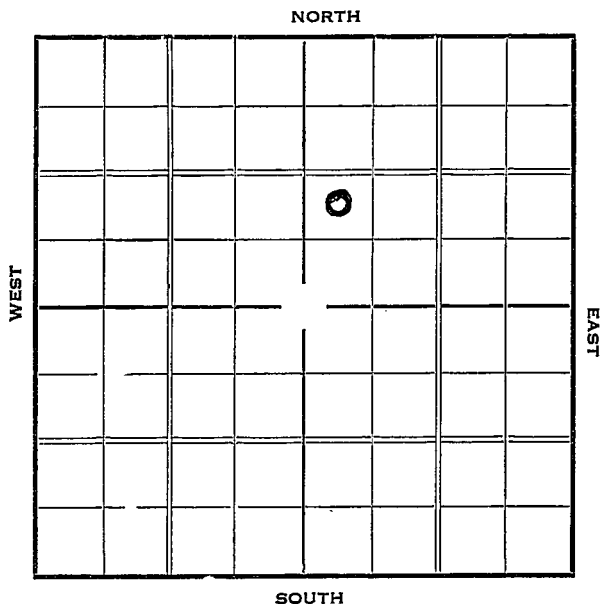


Section 33 Township 19 Range 10-WWell Number 2 HathawayCompany Shell

Sec. 33 Twp. 19 R. 10-WWell No. #2 Hathaway FarmShell Company Ft. from N. Line990 Ft. from S. Line Ft. from E. Line330 Ft. from W. Line

Elev. 1786

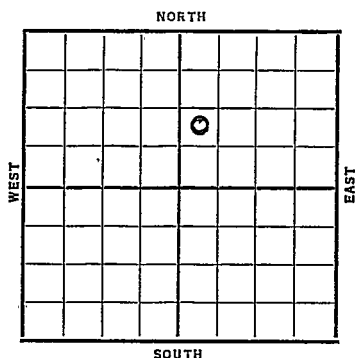

Date	REPORT
1937	
5/12	B. R.
5/21	12" @ 187'. Drlg. 1675'.
5/28	T.D. 3284'. C.O.
6/4	Sil. & 7" @ 3305'.
	T.D. 3331'. RUST.
6/11	T.D. 3331'. 5 bbls. oil per
	hour Nat. 1000 acid.
	No increase. Preparing to
	shoot.
6/19	" "
6/25	" "
7/2	" "
7/9	" "
7/16	20 qts. 3317-3327'.
	500' oil.
	OVER

1937

7/21

Sil 3305'

7" @ 3305'

TD 3331'

1000 acid - no increase

Shot 20 qts

4000 acid

5000 acid

Pump 325 oil & 75 water in
6 hrs.

Pot 1172

COMPLETED

Rice KANSAS

Map No. 46 Sec. 33 Twp. 19 R. 10^wWell No. 2 - HathawayShell Company

Contractor

FIRST REPORT

SECTION PLAT

		0	

 Ft. from N. Line990 Ft. from S. Line Ft. from E. Line330 Ft. from W. LineLocation Rig up

Drilling and Remarks:

B.R.

RECORD

Cased in., ft.Sand Gas Oil Total Depth

PRODUCTION

1st 24 hrs. Nat. 1st 24 hrs. after shot Gas Cu. Ft.Dry Hole Abandoned

Date

MAY 12 1937

19

H. D. Hatfield Scout

[Handwritten signature]
[Handwritten signature]

Returned	<i>[initials]</i>
Cards	<i>[initials]</i>
Tracing	<i>[initials]</i>
France Map	<i>[initials]</i>
Scarborough Map	<i>[initials]</i>
Moody Map	<i>[initials]</i>
Scarborough Plat Book	
Moody Plat Book	

Rice

Map No. 46 Sec. 33 Twp. 19 R. 10 WWell No. 2 - HathawayShell Company

Contractor

COMPLETED

SECTION PLAT

		0	

_____ Ft. from N. Line

990 Ft. from S. Line

_____ Ft. from E. Line

330 Ft. from W. Line

Location _____

Rig up _____

Drilling and Remarks:

1000 Acid - no increaseShot 20 gto4000 Acid5000 ✓Pump 325 oil
75 wat / 6 hrsPOT - 1172

RECORD

Cased 7 in., 3305 ft.Sand Sil 3305

Gas _____

Oil _____

Total Depth 3331

PRODUCTION

1st 24 hrs. Nat. _____

1st 24 hrs. after shot _____

Gas _____ Cu. Ft.

Dry Hole _____

Abandoned _____

Date

JUL 21 1937H. D. Hatfield

Scout

Returned
Cards *J. H. W.*
Tracing *me*
France Map *me*
Scarborough Map *me*
Moody Map *me*
Scarborough Plat Book
Moody Plat Book