


Section 33 Township 19 Range 10-W

Well Number 1 Hathaway

Company Barnsdall

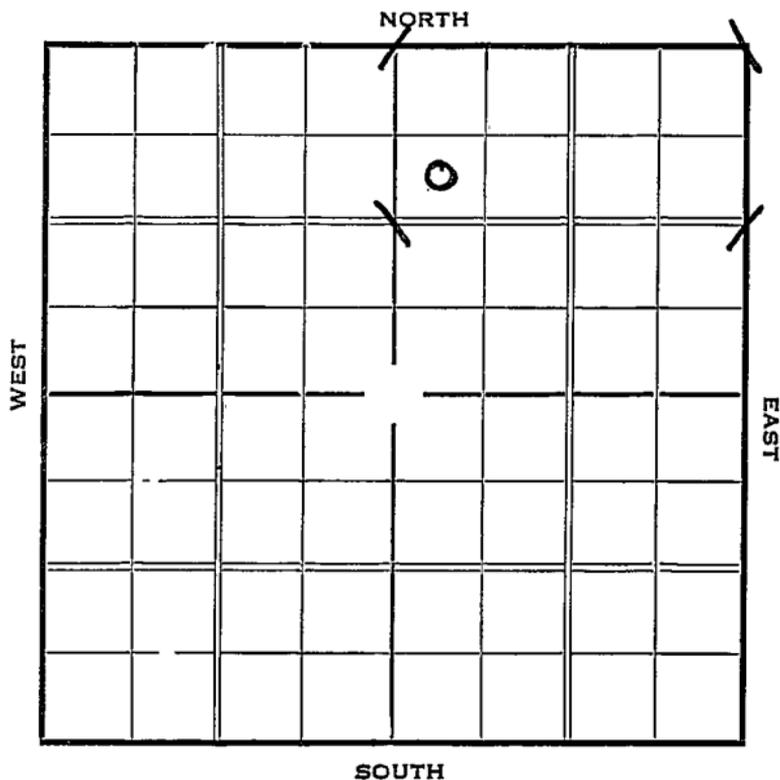

Sec. 33 Twp. 19 R. 10-W

Well No. #1 Hathaway Farm

Barnsdall Company


990 Ft. from N. Line

_____ Ft. from S. Line

_____ Ft. from E. Line

330 Ft. from W. Line

Elev. 1773

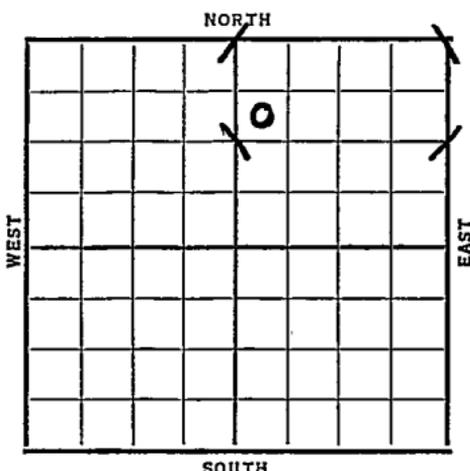

Date	REPORT
1937	
3/31	Rig
4/8	12" @ 191'
4/16	Drlg. 2405'.
4/23	Sil. 3272' set 7". T.D. 3280'. WOC.
4/30	T.D. 3284'. 1500 acid. Pumped 1008 24 hrs. Will Retest.
5/7	T.D. 3284'. Rng. liner.
5/14	" " " " "
5/21	" " " " "
5/26	7" @ 3272'. Sil. 3272'. T.D. 3284'. Pot. 2155 bbls.
	COMPLETED

KANSAS *Rice*

Map No. _____ Sec. 33 Twp. 19 R. 10W

Well No. 1 Hathaway

Barnsdall Company

Contractor _____

SECTION PLAT

990 Ft. from N. Line

_____ Ft. from S. Line

_____ Ft. from E. Line

330 Ft. from W. Line

FIRST REPORT

Location _____

Rig up _____

Drilling and Remarks:

Rig

RECORD

Cased _____ in., _____ ft.

Sand _____

Gas _____

Oil _____

Total Depth _____

PRODUCTION

1st 24 hrs. Nat. _____

1st 24 hrs. after shot _____

Gas _____ Cu. Ft.

Dry Hole _____

Abandoned _____

Date

MAR 31 1937 19

S. J. LEWIS

Scout

Rice KANSASMap No. _____ Sec. 33 Twp. 19 R. 10^wWell No. 1-HathawayBurnsdall Company

Contractor _____

COMPLETED**SECTION PLAT**990 Ft. from N. Line

_____ Ft. from S. Line

_____ Ft. from E. Line

330 Ft. from W. Line

		0	

Location _____

Rig up _____

Drilling and Remarks:

RECORDCased 7 in., 3272ft.Sand 511 3272

Gas _____

Oil _____

Total Depth 3284**PRODUCTION**

1st 24 hrs. Nat. _____

1st 24 hrs. after shot _____

Gas _____ Cu. Ft.

Dry Hole _____

Abandoned _____

Date

MAY 26 1937 19

H. D. Hatfield

Scout