


Rice

Section 33 Township 19 Range 10-W

Well No. 4 - Hathaway

Company Barnsdall

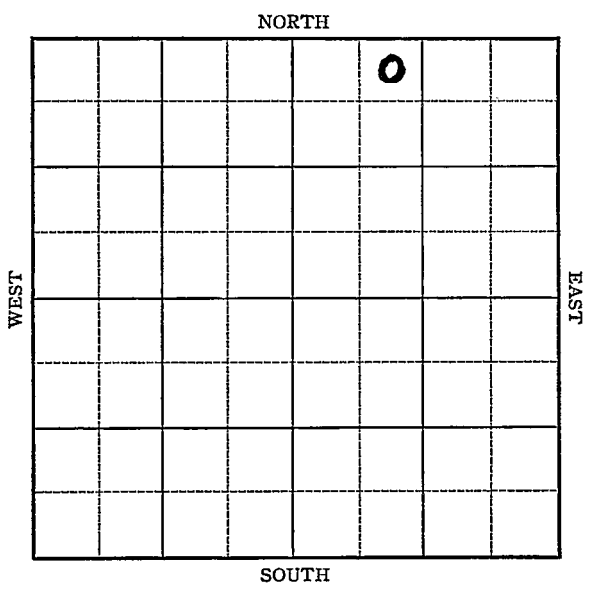

Rice KANSAS

Map No. 46 Sec. 33 Twp. 19 R. 10 W.Well No. 4 - HathawayBarnsdall Company

Contractor

FIRST REPORT

SECTION PLAT

		0	

330 Ft. from N. Line100 Ft. from S. Line100 Ft. from E. Line990 Ft. from W. Line

Location _____

Rig up _____

Drilling and Remarks:

R. U. R.

RECORD

Cased _____ in., _____ ft.

Sand _____

Gas _____

Oil _____

Total Depth _____

PRODUCTION

1st 24 hrs. Nat. _____

1st 24 hrs. after shot _____

Gas _____ Cu. Ft.

Dry Hole _____

Abandoned _____

Date

JUN 2 1937

19

H. D. Hatfield

Scout

Map No. _____ Sec. 33 Twp. 19 R. 10. WWell No. 4-HathawayBarnsdall Company

Contractor _____

COMPLETED**SECTION PLAT**

		0	

330 Ft. from N. Line

_____ Ft. from S. Line

_____ Ft. from E. Line

990 Ft. from W. Line

Location _____

Rig up _____

Drilling and Remarks:

1500 A,Pump 533/6Pot - 1921**RECORD**Cased 7 in. 3272 ft.Sand 511 3271

Gas _____

Oil _____

Total Depth 3286.**PRODUCTION**

1st 24 hrs. Nat. _____

1st 24 hrs. after shot _____

Gas _____ Cu. Ft.

Dry Hole _____

Abandoned _____

Date

JUN 30 1937 19H. D. Hatfield

Scout