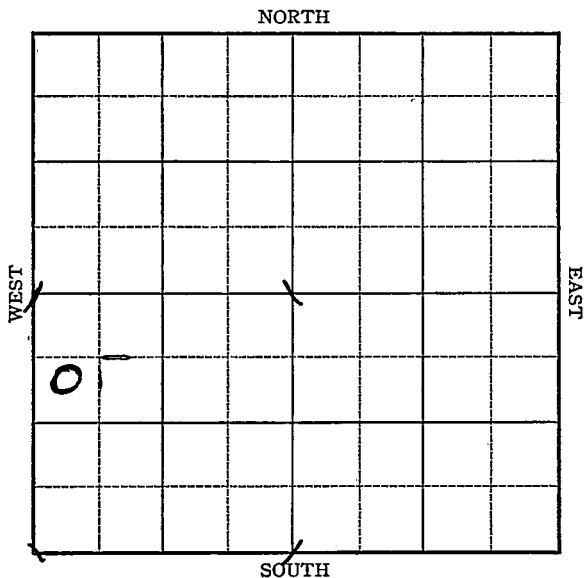


Rice

KANSAS

Section 33 Township 19 Range 10-WWell No. 2 - W. F. HathawayCompany Stanolind


Rice **KANSAS**Map No. _____ Sec. 33 Twp. 19 R. 10 WWell No. 2 - W. F. HathawayStanolind Company

Contractor _____

FIRST REPORT**SECTION PLAT**792 Ft. from N. Line

_____ Ft. from S. Line

_____ Ft. from E. Line

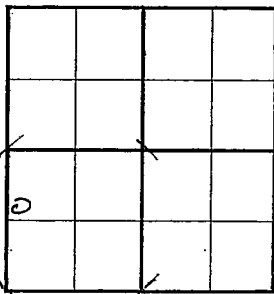330 Ft. from W. Line

Location _____

Rig up _____

Drilling and Remarks:

B.R.R.**RECORD**

Cased _____ in., _____ ft.

Sand _____

Gas _____

Oil _____

Total Depth _____

PRODUCTION

1st 24 hrs. Nat. _____

1st 24 hrs. after shot _____

Gas _____ Cu. Ft.

Dry Hole _____

Abandoned _____

Date

AUG 4 - 1937

19

H. D. Hatfield

Scout

KANSAS

Map No. _____ Sec. 33 Twp. 19 R. 10WWell No. 2- W. F. Hathaway
Stanford Company

Contractor _____

COMPLETED792 Ft. from N. Line

_____ Ft. from S. Line

_____ Ft. from E. Line

330 Ft. from W. Line

SECTION PLAT

Location _____

Rig up _____

Drilling and Remarks:

potential
2440 fols
nat.

RECORD

Cased 7 in., 3277 ft.Sand Delicious 3277

Gas _____

Oil Wt.Total Depth 3292

PRODUCTION

1st 24 hrs. Nat. _____

1st 24 hrs. after shot. _____

Gas _____ Gu. Ft.

Dry Hole _____

Abandoned _____

Date

SEP 8 1937

19

H. D. Hatfield

Scout