


Rice

KANSAS

Section 33 Township 19 Range 10-W

Well No. #5 Hathaway

Company Stanolind

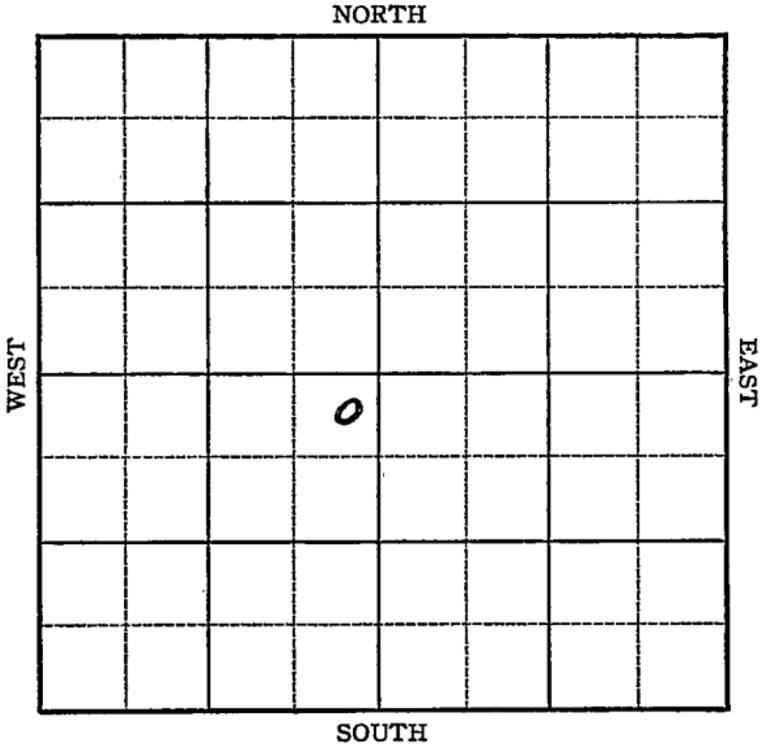


Sec. 33 Twp. 19 R. 10-WWell No. #5 Hathaway FarmStarolind Company330 Ft. from N. Line

\_\_\_\_\_ Ft. from S. Line

330 Ft. from E. Line

\_\_\_\_\_ Ft. from W. Line

Elev. 1781

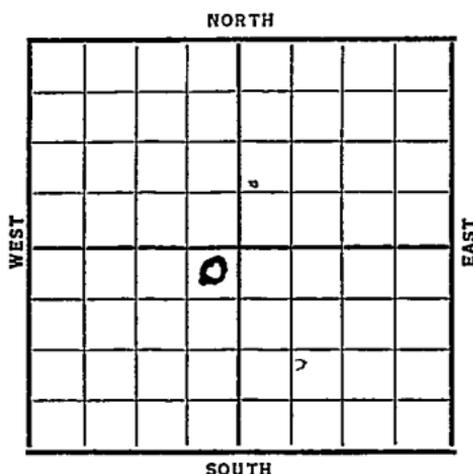

Date	REPORT
1937	
9/22	R. R.
10/2	10" @ 202'. WOC.
10/8	Drlg. 3180'.
10/15	Sil. 3328'. Coring 3336'. No shows.
10/20	10" @ 202'. Sil. 3328'. T.D. 3353'. No shows.
	<b>ABANDONED</b>

*Rice* KANSASMap No. \_\_\_\_\_ Sec. 33 Twp. 19 R. 1025Well No. 5 HathawayStanolind Company

Contractor \_\_\_\_\_

## FIRST REPORT

330 Ft. from N. Line

\_\_\_\_\_ Ft. from S. Line

330 Ft. from E. Line

\_\_\_\_\_ Ft. from W. Line

## SECTION PLAT

		○	

Location \_\_\_\_\_

Rig up \_\_\_\_\_

Drilling and Remarks:

*P.R.*

## RECORD

Cased \_\_\_\_\_ in., \_\_\_\_\_ ft.

Sand \_\_\_\_\_

Gas \_\_\_\_\_

Oil \_\_\_\_\_

Total Depth \_\_\_\_\_

## PRODUCTION

1st 24 hrs. Nat. \_\_\_\_\_

1st 24 hrs. after shot \_\_\_\_\_

Gas \_\_\_\_\_ Cu. Ft.

Dry Hole \_\_\_\_\_

Abandoned \_\_\_\_\_

Date

SEP 22 1937 19 H. D. Hatfield Scout

Rice

KANSAS

Map No. \_\_\_\_\_ Sec. 33 Twp. 19 R. 10W

Well No. 5 Hathaway

Stanolind Company

Contractor \_\_\_\_\_

ABANDONED

NE SW

330 Ft. from N. Line

\_\_\_\_\_ Ft. from S. Line

330 Ft. from E. Line

\_\_\_\_\_ Ft. from W. Line

SECTION PLAT

	0		

Location \_\_\_\_\_

Rig up \_\_\_\_\_

Drilling and Remarks:

*No Shows.*

*D & A*

*10" - 202*  
RECORD

Cased \_\_\_\_\_ in., \_\_\_\_\_ ft.

Sand *511 3328*

Gas \_\_\_\_\_

Oil \_\_\_\_\_

Total Depth 3353

PRODUCTION

1st 24 hrs. Nat. \_\_\_\_\_

1st 24 hrs. after shot \_\_\_\_\_

Gas \_\_\_\_\_ Cu. Ft.

Dry Hole \_\_\_\_\_

Abandoned \_\_\_\_\_

Date

OCT 20 1937<sub>19</sub>

H. D. Hatfield Scout