


Section 33 Township 19 Range 10-W

Well Number #4 Hathaway

Company Shell

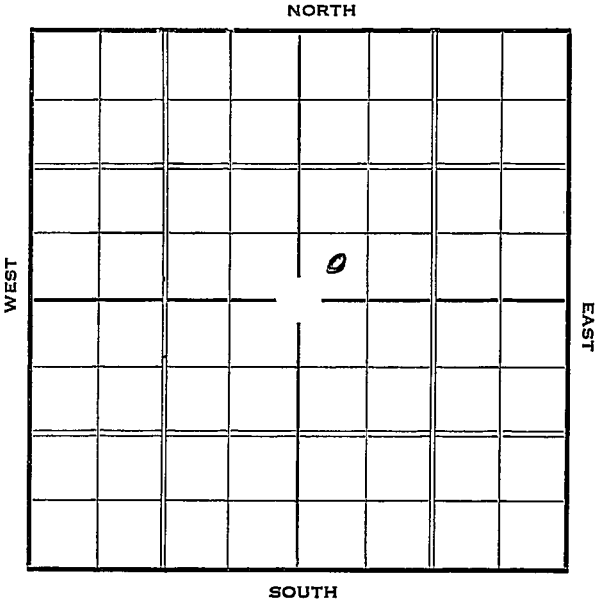

Rice

KANSAS

Map No. _____ Sec. 33 Twp. 19 R. 10WWell No. 4 HathawayShell

Company

Contractor

FIRST REPORT

SW NE

_____ Ft. from N. Line

330 Ft. from S. Line

_____ Ft. from E. Line

330 Ft. from W. Line

SECTION PLAT

		O	

Location _____

Rig up _____

Drilling and Remarks:

SH

RECORD

Cased _____ in., _____ ft.

Sand _____

Gas _____

Oil _____

Total Depth _____

PRODUCTION

1st 24 hrs. Nat. _____

1st 24 hrs. after shot _____

Gas _____ Cu. Ft.

Dry Hole _____

Abandoned _____

Date

OCT 13 1937 19 _____ H. D. Hatfield Scout

Rice KANSAS

Map No. _____ Sec. 33 Twp. 19 R. 10WWell No. 4 Hathaway

Shell Petroleum Company

Contractor

COMPLETED

SW NE

_____ Ft. from N. Line

330 Ft. from S. Line

_____ Ft. from E. Line

330 Ft. from W. Line

SECTION PLAT

		0	

Location _____

Rig up _____

Drilling and Remarks:

*2000 acid**POT-1735**M*

RECORD

Cased 7 in. 3295 ft.Sand 511 3295

Gas _____

Oil _____

Total Depth 3306

PRODUCTION

1st 24 hrs. Nat. _____

1st 24 hrs. after shot _____

Gas _____ Cu. Ft.

Dry Hole _____

Abandoned _____

Date

NOV 10 1937 19 H. D. Hatfield Scout