


RICE

KANSAS

Section 33 Township 19 Range 10W

Well Number 3 Knop (Knox)

Company Gulf

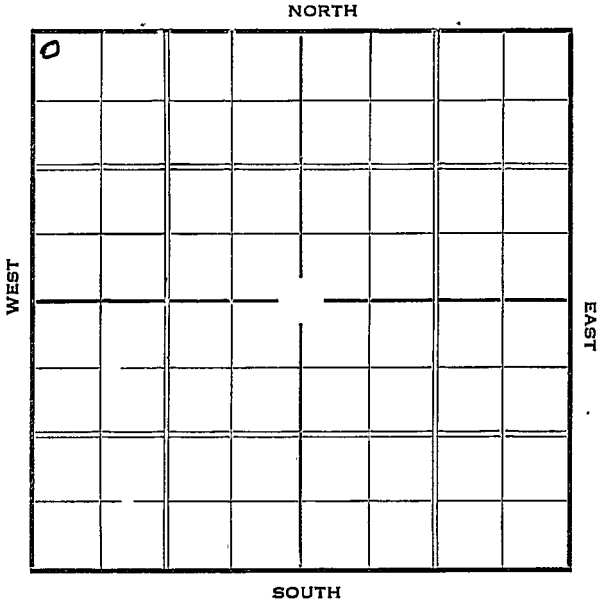

KANSAS

Map No. 46 Sec. 83 Twp. 19 R. 10W

Well No. 3 Knopf

Gulf Company

Contractor

SECTION PLAT

330 Ft. from N. Line

_____ Ft. from S. Line

_____ Ft. from E. Line

330 Ft. from W. Line

0			

FIRST REPORT

Location _____

Rig up _____

Drilling and Remarks:

Ponds.

RECORD

Cased _____ in., _____ ft.

Sand _____

Gas _____

Oil _____

Total Depth _____

PRODUCTION

1st 24 hrs. Nat. _____

1st 24 hrs. after shot _____

Gas _____ Cu. Ft.

Dry Hole _____

Abandoned _____

Date

JAN 13 1937

19

S. J. LEWIS Scout

Map No. _____ Sec. 33 Twp. 19 R. 10W

Well No. 3 Knopf

Gulf Company

Contractor

SECTION PLAT

330 Ft. from N. Line

_____ Ft. from S. Line

_____ Ft. from E. Line

330 Ft. from W. Line

0			

REGISTERED

Location _____

Rig up _____

Drilling and Remarks:

Sil 3270 1/2
Potential
1781 natural

RECORD

Cased _____ in., _____ ft.

Sand _____

Gas _____

Oil _____

Total Depth 3286

PRODUCTION

1st 24 hrs. Nat. _____

1st 24 hrs. after shot _____

Gas _____ Cu. Ft.

Dry Hole _____

Abandoned _____

Date

FEB 24 1937 19

S. J. LEWIS

Scout