


Map No. KANSAS Sec. 33 Twp. 19 R. 10W

Well No. #1 Knop Farm (KNOX)
Gulf. Company

NORTH

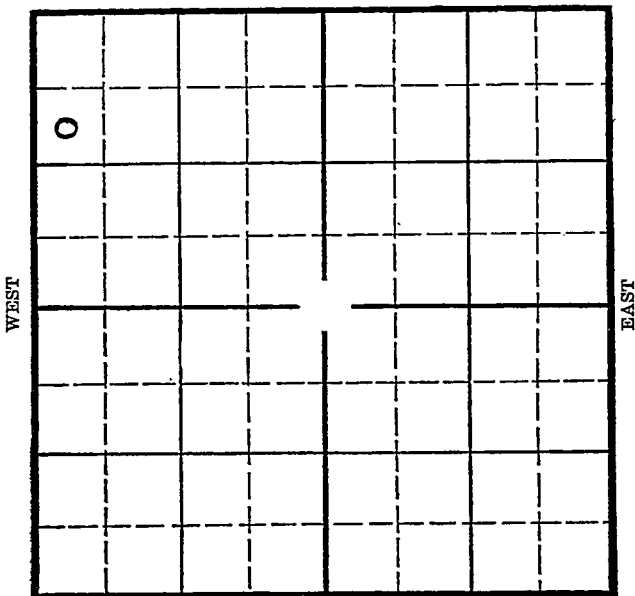

Location _____

Drilling Remarks _____

RECORD

Cased _____ in. _____ ft.

Sand _____

Gas _____

Oil _____

Total Depth _____

Rig Up _____

Drilling Remarks _____

PRODUCTION

1st 24 hrs. Nat. _____

1st 24 hrs. after shot _____

Gas _____ cu. ft. _____

Dry Hole _____

Abandoned _____

Map No. **KANSAS** Sec. 33 Twp. 19 R. 10-W

Well No. 1-Knop Farm


Gulf Company

990 Ft. from N. Line

_____ Ft. from S. Line

_____ Ft. from E. Line

330 Ft. from W. Line

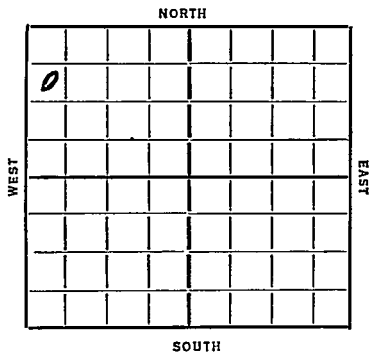

Elev. 1781

Date	REPORT
1936	
4/8	Rig
4/16	10" @ 185' Drlg. 985'
4/23	Drlg. 2750'
4/30	Sil. 3272'. T.D. 3275'. R.U.S.T.
5/7	Oil 3277-3289'-92-3100' oil 1/2 BW B.P. 3287'.
5/13/36	Sil. 3272'. XXXXXXXXXX '. XXXXXXXXXX XXXXXXXXXX '. XXXXXXXXXX . XXXXXXXXXX XXXXXXXXXX XXXXXXXXXXXXXXXXXXXX COMPLETED
	Top Siliceous 3272
	Oil 3277-89
	T.D. 3292'
	1/2 Bailer water
	P.B. to 3287
	1000 Acid
	995 Barrels Oil

Map No. 46 Sec. 33 Twp. 19 R. 10 W

Well No. 1 Knopf

Gulf Company

Contractor

SECTION PLAT

990 Ft. from N. Line

_____ Ft. from S. Line

_____ Ft. from E. Line

330 Ft. from W. Line

0			

0.11177

Location _____

Rig up _____

Drilling and Remarks:

Sil 3272
P.B. 3287
1000 acid

995 ft.

RECORD

Cased _____ in., _____ ft.

Sand _____

Gas _____

Oil _____

Total Depth 3100

PRODUCTION

1st 24 hrs. Nat. _____

1st 24 hrs. after shot _____

Gas _____ Cu. Ft.

Dry Hole _____

Abandoned _____

Date

MAY 13 1936

19

S. J. LEWIS

Scout

INDAS

Map No. 46 Sec. 33 Twp. 19 R. 10 W

Well No. 1 Knappa

Galy Company

Contractor

SECTION PLAT

990 Ft. from N. Line

..... Ft. from S. Line

..... Ft. from E. Line

330 Ft. from W. Line

0			

FIRST REPORT

Location.....

Rig up.....

Drilling and Remarks:

Rig

RECORD

Cased.....in.,ft.

Sand.....

Gas.....

Oil.....

Total Depth.....

PRODUCTION

1st 24 hrs. Nat.....

1st 24 hrs. after shot.....

Gas.....Cu. Ft.

Dry Hole.....

Abandoned.....

Date

4/8/36 192.....

S. J. LEWIS Scout