


Section 33 Township 19 Range 10-W

Well Number 5 Knop *(Knox?)*

Company Gulf

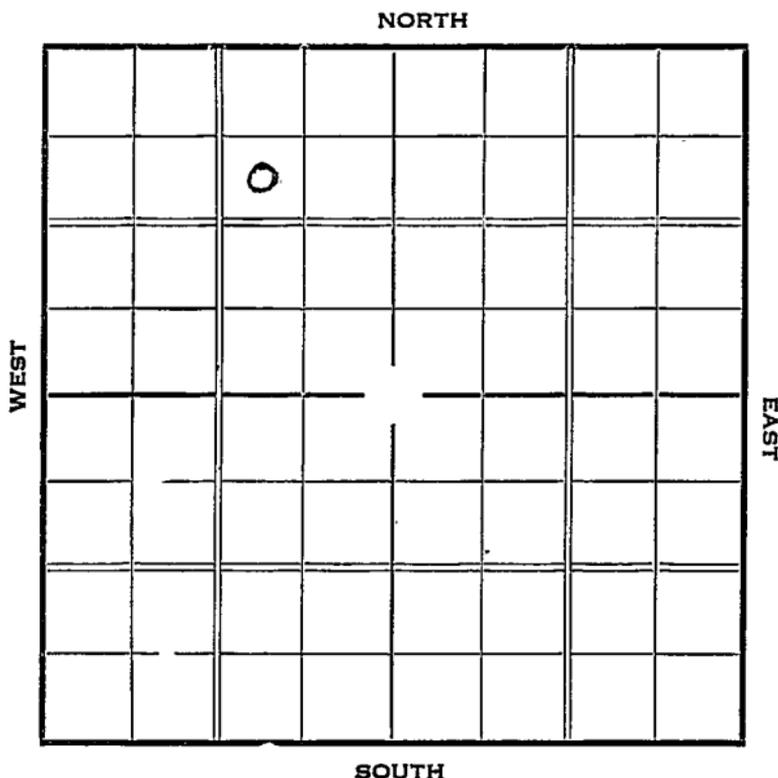

Sec. 35 Twp. 19 R. 10-W

Well No. #5 Knop Farm

Gulf Company


990 Ft. from N. Line

_____ Ft. from S. Line

990 Ft. from E. Line

_____ Ft. from W. Line

Elev. 1777

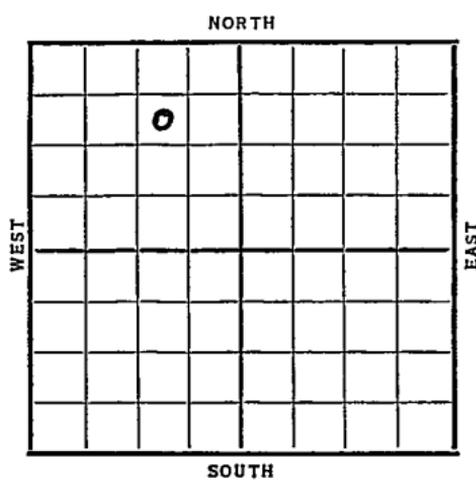

Date	REPORT
1937	
2/17	Rig
2/26	Drlg. 127'.
3/4	Drlg. 2336'.
3/11	Sil. 3372 $\frac{1}{2}$ ". 6" @ 3278 $\frac{1}{2}$ ". RUST
3/18	TD 3290' Testing
3/24	Sil. 3278 $\frac{1}{2}$ '.
	T. D. 3290'.
	1000 acid.
	Potential 1114.
	COMPLETED

KANSAS

Map No. 46 Sec. 33 Twp. 19 R. 10W

Well No. 5 Knopf

Gulf Company

Contractor

SECTION PLAT

	0		

990 Ft. from N. Line

_____ Ft. from S. Line

990 Ft. from E. Line

_____ Ft. from W. Line

FIRST REPORT

Location _____

Rig up _____

Drilling and Remarks:

Rig

RECORD

Cased _____ in., _____ ft.

Sand _____

Gas _____

Oil _____

Total Depth _____

PRODUCTION

1st 24 hrs. Nat. _____

1st 24 hrs. after shot _____

Gas _____ Cu. Ft.

Dry Hole _____

Abandoned _____

Date

FEB 17 1937 19

S. J. LEWIS Scout

KANSAS *Rice*

Map No. 41 Sec. 33 Twp. 19 R. 10W

Well No. 5 Knop

Gulf Company
Contractor

SECTION PLAT

	o		
			•

990 Ft. from N. Line

_____ Ft. from S. Line

990 Ft. from E. Line

_____ Ft. from W. Line

COMPLETED

RECORD

Location _____

Cased _____ in., _____ ft.

Rig up _____

Sand _____

Drilling and Remarks:

Gas _____

Oil 3278 1/2

Oil _____

Total Depth 3290

1000 acid

Potential

1114

PRODUCTION

1st 24 hrs. Nat. _____

1st 24 hrs. after shot _____

Gas _____ Cu. Ft.

Dry Hole _____

Abandoned _____

Date

12 9 1927

19

S. I. LEWIS Scout