


Section 33 Township 19 Range 10-W

Well No. 8 - M. Panning

Company Stanolind

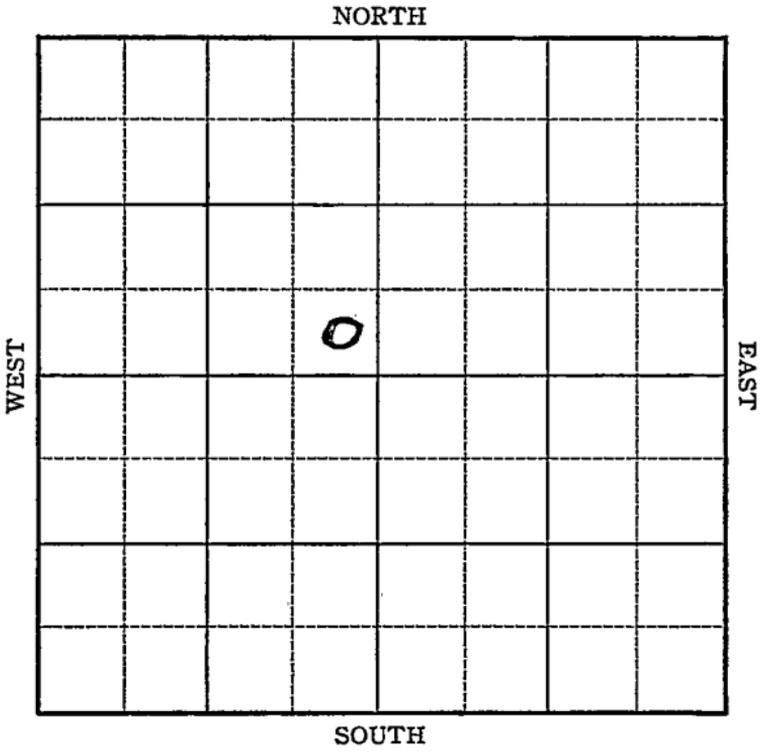

# KANSAS Rice

Sec. 33 Twp. 19 R. 10-W

Well No. #8 M. Panning Farm


Stanolind Company

\_\_\_\_\_ Ft. from N. Line

330 Ft. from S. Line

330 Ft. from E. Line

\_\_\_\_\_ Ft. from W. Line

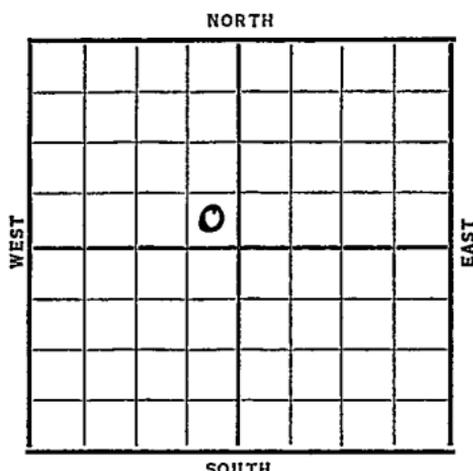

Elev. 1777

Date	REPORT
1937	
9/1	B.R.R.j
9/10	R U R
9/17	12" @ 210'. Anhy 480'. Drl g. 2340'.
9/24	Sil. 3283'. T.D. 3287'. 7" @ 3283'. Sat. Core. RUST.
10/2	T.D. 3301'. 2500' oil.
10/8	Swab 20 B.O. 2 hrs. 2000 acid. Swab 82 B.O. in 2 hrs. 2000 acid. Swab 150 B.O. in 2 hrs.
10/13	7" @ 3283'. Sil. 3283'. T.D. 3301'. 2000 acid. 2000 acid. Potential 1353 bbls.
	<b>COMPLETED</b>

Pice KANSAS

Map No. 46 Sec. 33 Twp. 19 R. 10WWell No. J-M. Fanning  
Stanolind Company

Contractor

## FIRST REPORT

## SECTION PLAT

     Ft. from N. Line330 Ft. from S. Line330 Ft. from E. Line     Ft. from W. Line

	0		

Location     Rig up     

Drilling and Remarks:

BRR

## RECORD

Cased      in.,      ft.Sand     Gas     Oil     Total Depth     

## PRODUCTION

1st 24 hrs. Nat.     1st 24 hrs. after shot     Gas      Cu. Ft.Dry Hole     Abandoned     

Date

SEP 1 1937H. D. Hatfield Scout

Rice

KANSAS

Map No. \_\_\_\_\_ Sec. 33 Twp. 19 R. 10WWell No. 8 M PanningStanolind

Company

Contractor

COMPLETED

SE NW

\_\_\_\_\_ Ft. from N. Line

330 Ft. from S. Line330 Ft. from E. Line

\_\_\_\_\_ Ft. from W. Line

SECTION PLAT

		0	

Location \_\_\_\_\_

Rig up \_\_\_\_\_

Drilling and Remarks:

2000 Acid2000 ✓POT-1353

RECORD

Cased 7 in., 3283 ft.Sand 511 3283

Gas \_\_\_\_\_

Oil \_\_\_\_\_

Total Depth 3301

PRODUCTION

1st 24 hrs. Nat. \_\_\_\_\_

1st 24 hrs. after shot \_\_\_\_\_

Gas \_\_\_\_\_ Cu. Ft.

Dry Hole \_\_\_\_\_

Abandoned \_\_\_\_\_

Date

OCT 13 1937 19H. D. Hatfield Scout