

Rice


KANSAS

Form 51-5M 5-37 Petrol

Section 33 Township 19 Range 10-W

Well No. 7 - M. Panning

Company Stanolind

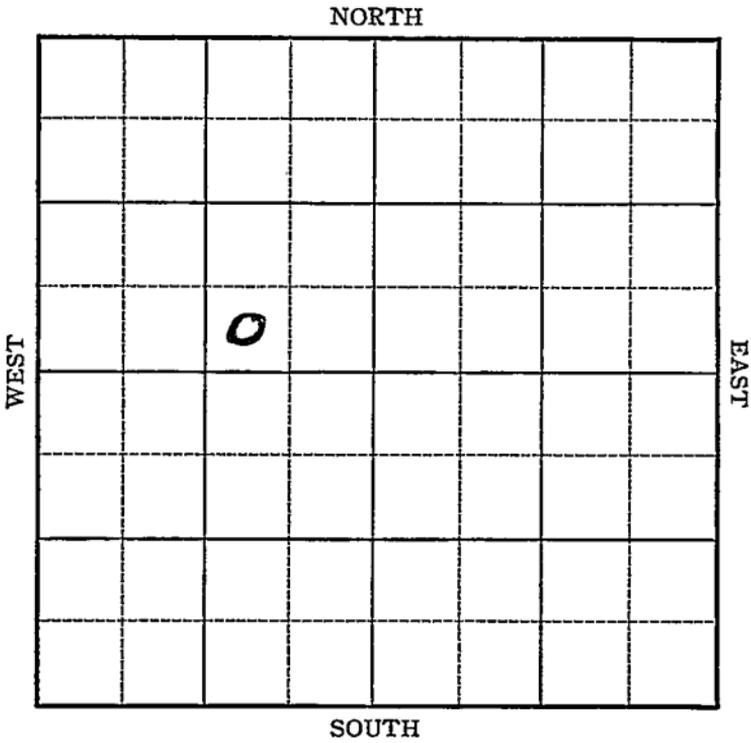

Sec. 33 Twp. 19 R. 10W

Well No. #7 M. Panning Farm

Stanolind Company


SW SE NW

_____ Ft. from N. Line

330 Ft. from S. Line

990 Ft. from E. Line

_____ Ft. from W. Line

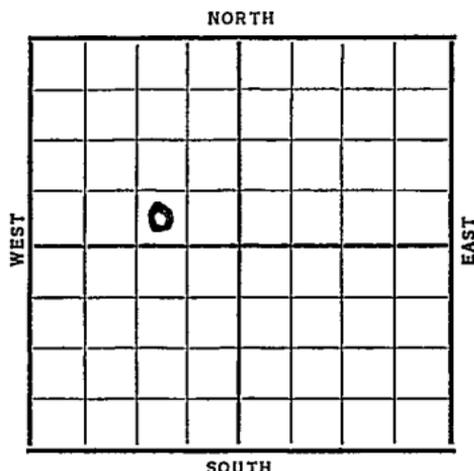

Date	REPORT
1937	
8/25	R.U.R.
9/3	10" @ 216'. Drlg. 2130'.
9/10	Sil. 3280 & 6". T.D. 3283'. RUST. No shows repl
9/17	" " " "
9/24	T.D. 3292'. Swab 96 bbls. P.H. 2000 acid.
9/29	6" @ 3280'. Sil. 3280'. T.D. 3292'. 2000 acid.
	Pot. 2408 bbls.
	COMPLETED

Rice KANSAS

Map No. _____ Sec. 33 Twp. 19 R. 10W

Well No. 7-M. Panning

Stanolind Company

FIRST REPORT Contractor

sw se nw

SECTION PLAT

	0		

_____ Ft. from N. Line

330 Ft. from S. Line

990 Ft. from E. Line

_____ Ft. from W. Line

Location _____

Rig up _____

Drilling and Remarks:

R U R

RECORD

Cased _____ in., _____ ft.

Sand _____

Gas _____

Oil _____

Total Depth _____

PRODUCTION

1st 24 hrs. Nat. _____

1st 24 hrs. after shot _____

Gas _____ Cu. Ft.

Dry Hole _____

Abandoned _____

Date

AUG 25 1937

19

H. D. Hatfield

Scout

Map No. _____ Sec. 33 Twp. 19 R. 10WWell No. 7- M PanningStanolind Company

Contractor _____

COMPLETED

SW SE NW

____ Ft. from N. Line

330 Ft. from S. Line990 Ft. from E. Line

____ Ft. from W. Line

SECTION PLAT

	0		

Location _____

Rig up _____

Drilling and Remarks:

*2000 acid**Port. 2408'*

RECORD

Cased 6 in., 3280 ft.Sand 511 3280

Gas _____

Oil _____

Total Depth 3292

PRODUCTION

1st 24 hrs. Nat. _____

1st 24 hrs. after shot _____

Gas _____ Cu. Ft.

Dry Hole _____

Abandoned _____

Date

SEP 29 1937 19

H. D. Hatfield

Scout