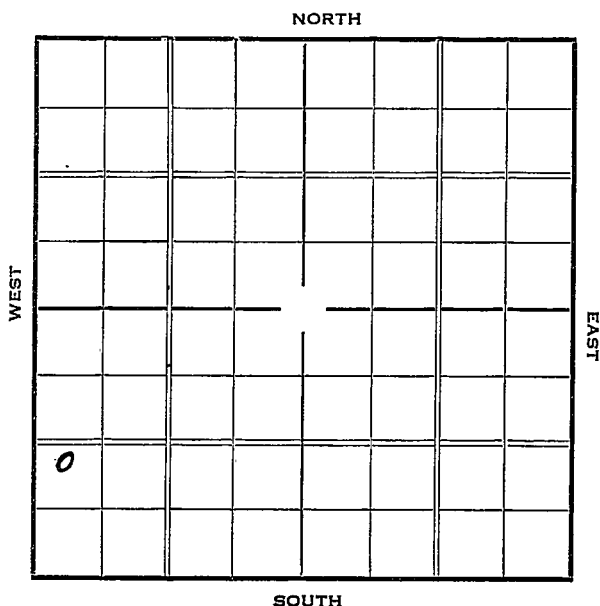


Rice

KANSAS

Section 33 Township 19 Range 10-WWell Number 3 - RisseCompany Carter

KANSAS

Rice

Sec. 33 Twp. 19 R. 10-W


Well No. #3 Risse Farm
Carter Company

_____ Ft. from N. Line

1188 Ft. from S. Line

_____Ft. from E. Line

330 Ft. from W. Line

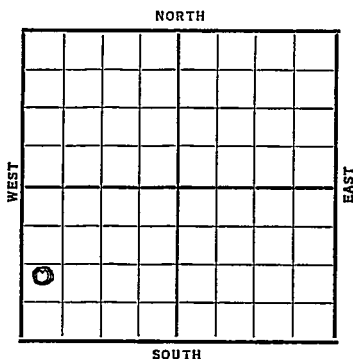[illegible]

Rice KANSASMap No. _____ Sec. *33* Twp. *19* R. *10* W.Well No. *3 - Risse**Carter* Company

Contractor _____

FIRST REPORT

_____ Ft. from N. Line

1188 Ft. from S. Line

_____ Ft. from E. Line

330 Ft. from W. Line

SECTION PLAT

<i>0</i>			

Location _____

Rig up _____

Drilling and Remarks:

R.R.

RECORD

Cased _____ in., _____ ft.

Sand _____

Gas _____

Oil _____

Total Depth _____

PRODUCTION

1st 24 hrs. Nat. _____

1st 24 hrs. after shot _____

Gas _____ Cu. Ft.

Dry Hole _____

Abandoned _____

Date

JUL 14 1937 19*H. D. Hatfield*

Seput

Rice **KANSAS**Map No. _____ Sec. *33* Twp. *19* R. *10 W*Well No. *3-Risse**Carter*

Company

Contractor

COMPLETED**SECTION PLAT**

0			

_____ Ft. from N. Line

1188 Ft. from S. Line

_____ Ft. from E. Line

330 Ft. from W. Line

Location _____

Rig up _____

Drilling and Remarks:

RECORDCased *7 in., 3289* ft.Sand *511 3289*

Gas _____

Oil _____

Total Depth *3295***PRODUCTION**

1st 24 hrs. Nat. _____

1st 24 hrs. after shot _____

Gas _____ Cu. Ft.

Dry Hole _____

Abandoned _____

*Lot - 1897**NAT*

Date

AUG 25 1937

19

H. D. Hatfield Scout