
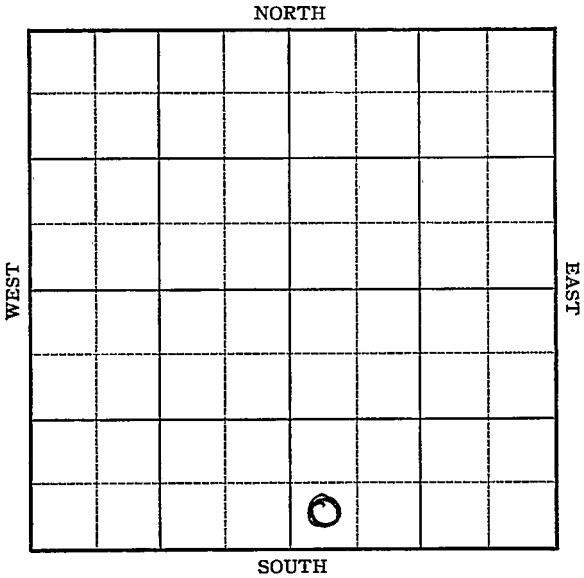


Section 33 Township 19 Range 10-W

Well No. 5 - Schartz

Company Texas

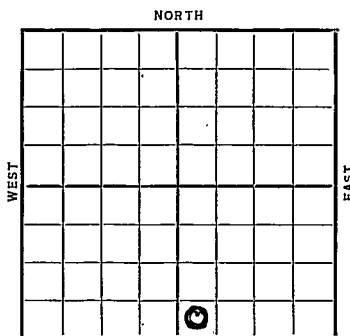

Sec. 33 Twp. 19 R. 10-WWell No. #5 Schartz Farm
Texas Company Ft. from N. Line330 Ft. from S. Line Ft. from E. Line330 Ft. from W. Line

SPECAIL Offset #6 wood.

Date	Elev. 1787	REPORT
1937		
6/9	Location	
6/19	Cellar	
6/25	S. H.	
7/2	10" @ 160'. Drlg. 1800'.	
7/10	Siliceous 3315-21 T.D.	
	show oil in bottom Running pipe (Teleg)	
7/10	7" 3317 WOC Rust (Tel)	
7/15	Siliceous 3315-34 T.D.	
	1500 feet oil in 8 hours	
	Acidized with 1000 gallons (Tel)	
7/19	Pumped 376 bbls. 24 hours	
	Reacidized 1000 gallons Pumped	
	814 bbls. 22 hrs. Down 2 hrs. (Tel)	
7/19	Potential 926 bbls. oil 24 hours	
	Cutting $1\frac{1}{2}\%$ water (Telegram)	

OVER

1937

7/21

Sil 3315'

7" @ 3317'

TD 3334&

1000 acid

Pumped 376/24

1000 acid

Pot 926/24

COMPLETED

Rice KANSAS

Map No. 46 Sec. 53 Twp. 19 R. 10 WWell No. 5 - SchartzTexas Company

Contractor

FIRST REPORT

SECTION PLAT

_____ Ft. from N. Line

330 Ft. from Special Line

_____ Ft. from E. Line

330 Ft. from W. Lineoffset #6 wood

Location ✓

Rig up _____

Drilling and Remarks:

RECORD

Cased _____ in., _____ ft.

Sand _____

Gas _____

Oil _____

Total Depth _____

PRODUCTION

1st-24 hrs. Nat. _____

1st 24 hrs. after shot _____

Gas _____ Cu. Ft.

Dry Hole _____

Abandoned _____

Date

JUN 9 1937

19

H. D. Hatfield

Scout

Returned _____

Cards _____

Tracing _____

France Map _____

Scarborough Map _____

Moody Map _____

Scarborough Plat Book _____

Moody Plat Book _____

Rice

Map No. 46 Sec. 33 Twp. 19 R. 10^wWell No. 5-SchultzTexas Company

Contractor

COMPLETED

SECTION PLAT

		0	

_____ Ft. from N. Line

330 Ft. from S. Line

_____ Ft. from E. Line

330 Ft. from W. Line

Location _____

Rig up _____

Drilling and Remarks:

1000 AcidPumped 376/241000 AcidPat - 926/24

RECORD

Cased 7 in., 3317 ft.Sand 511 3315

Gas _____

Oil _____

Total Depth 3334

PRODUCTION

1st 24 hrs. Nat. _____

1st 24 hrs. after shot _____

Gas _____ Cu. Ft.

Dry Hole _____

Abandoned _____

Date

JUL 21 1937

19

H. D. Hatfield

Scout

Returned

Cards

Tracing

France Map

Scarborough Map

Moody Map

Scarborough Plat Book

Moody Plat Book