


Section 33 Township 19 Range 10-W

Well Number #1-B ~~#2~~-Schartz

Company Hartman & Blair

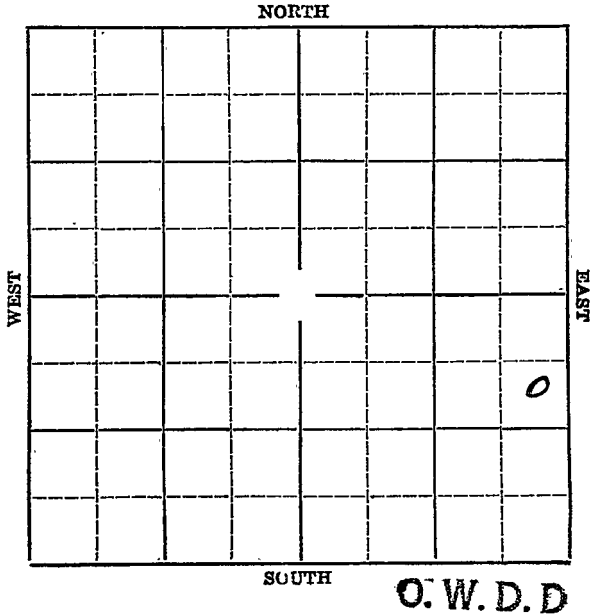

Rice

Map No. KANSAS Sec. 33 Twp. 19 R. 10W

Well No. ~~#1-B~~ ~~#2~~ Schartz Farm

Hartmen & Blair Company


~~990'~~ Ft. from N. Line

1659 Ft. from S. Line

330' Ft. from E. Line

_____ Ft. from W. Line

Elev. 1782

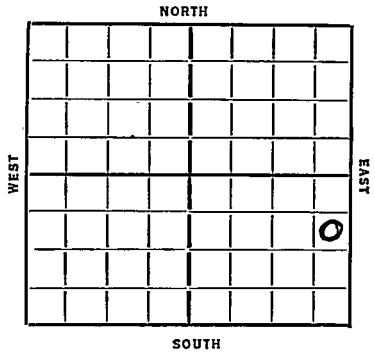

Date
1936

REPORT **O. W. D. D**

7/1 Location.

7/9 Building rig.

7/16 10" @ 211'. Drlg. 1190'.

~~7/23 2000 gallons of acid. Pumped 23 to 27 bbls of oil per hour for 10 hrs.~~

7/23 Dlg. 2610

7/30 Top Siliceous 3310 $\frac{1}{2}$ Slight saturation
T.D. 3311 (Telegram)

8/6 Total Depth 3320 Filled up 1900 feet in 8 hours No test yet (Tel)

8/10 Potential 440 bbls. (Tel)

8/12/36-Sil. 3310 $\frac{1}{2}$ '
T.D. 3320'
3000 gallons of acid.
440 bbls of oil potential.

COMPLETED
O. W. D. D

9/23/36 - Old total depth 3320'
Drilled to 3335
Testing.

OVER

9/30/36-Sil: 3313'. Corrected.
T.D. 3335 $\frac{1}{2}$ '.

Potential 1586 bbls of oil.

COMPLETED

5.32

Map No. 46 Sec. 33 Twp. 19 R. 10W

Well No. 2 Schartz

Hastman & Blair Company

Contractor

SECTION PLAT

990 Ft. from N. Line

_____ Ft. from S. Line

230 Ft. from E. Line

_____ Ft. from W. Line

			o

FIRST REPORT

Location ✓

Rig up _____

Drilling and Remarks:

RECORD

Cased _____ in., _____ ft.

Sand _____

Gas _____

Oil _____

Total Depth _____

PRODUCTION

1st 24 hrs. Nat. _____

1st 24 hrs. after shot _____

Gas _____ Cu. Ft.

Dry Hole _____

Abandoned: _____

Date

JUL 1 1936

19

S. J. LEWIS

Scout

[Handwritten signature]

Returned	<i>[Signature]</i>
Cards	<i>[Signature]</i>
Tracing	<i>[Signature]</i>
France Map	<i>[Signature]</i>
Scarborough Map	<i>[Signature]</i>
Moody Map	<i>[Signature]</i>
Scarborough Plat Book	
Moody Plat Book	

Map No. 46 Sec. 33 Twp. 19 R. 10W

Well No. 1-B Schartz

Hartman & Blair Company

Contractor

SECTION PLAT

			o

_____ Ft. from N. Line

1659 Ft. from S. Line

320 Ft. from E. Line

_____ Ft. from W. Line

CORRECTION

Location _____

Rig up _____

Drilling and Remarks:

*Changed Number
from 2 to 1-B*

RECORD

Cased _____ in., _____ ft.

Sand _____

Gas _____

Oil _____

Total Depth _____

PRODUCTION

1st 24 hrs. Nat. _____

1st 24 hrs. after shot _____

Gas _____ Cu. Ft.

Dry Hole _____

Abandoned _____

Date

7/23 1936

J. Lewis Scout

[Handwritten signature]

Returned	<i>[Handwritten mark]</i>
Cards	<i>[Handwritten mark]</i>
Tracing	<i>[Handwritten mark]</i>
Franco Map	<i>[Handwritten mark]</i>
Scarborough Map	<i>[Handwritten mark]</i>
Moody Map	<i>[Handwritten mark]</i>
Scarborough Flat Book	
Moody Flat Book	

KANSAS

Map No. 46 Sec. 33 Twp. 19 R. 10W

Well No. 1 B Scharfg

Hartman & Blair Company

Contractor

SECTION PLAT

			0

_____ Ft. from N. Line

1659 Ft. from S. Line

330 Ft. from E. Line

_____ Ft. from W. Line

COMPLETED

Location _____

Rig up _____

Drilling and Remarks:

Sil 33 10 1/2

3000 rods

Prod 440

RECORD

Cased _____ in., _____ ft.

Sand _____

Gas _____

Oil _____

Total Depth 3320

PRODUCTION

1st 24 hrs. Nat. _____

1st 24 hrs. after shot _____

Gas _____ Cu. Ft.

Dry Hole _____

Abandoned _____

Date

AUG 12 1936 19

S. J. LEWIS Scout

[Handwritten signature]

Returned	<i>[Signature]</i>
Cards	<i>[Signature]</i>
Tracing	<i>[Signature]</i>
France Map	<i>[Signature]</i>
Scarborough Map	<i>[Signature]</i>
Moody Map	<i>[Signature]</i>
Scarborough Plat Book	
Moody Plat Book	

KANSAS

Map No. 46 Sec. 33 Twp. 19 R. 10W

Well No. 1 Scharfe "B"

Hartman & Blair Company

Contractor

SECTION PLAT

			o

_____ Ft. from N. Line

1659 Ft. from S. Line

330 Ft. from E. Line

_____ Ft. from W. Line

FIRST REPORT

OW-111

Location _____

Rig up _____

Drilling and Remarks:

Old T.D 3320

Drilled & 3335

Testing

RECORD

Cased _____ in., _____ ft.

Sand _____

Gas _____

Oil _____

Total Depth _____

PRODUCTION

1st 24 hrs. Nat. _____

1st 24 hrs. after shot _____

Gas _____ Cu. Ft.

Dry Hole _____

Abandoned _____

Date

SEP 23 1936

19

S. J. LEWIS

Scout

17 x 22
12 11 19

[Large handwritten scribble]
[Signature]
[Signature]

Returned	<i>[Signature]</i>
Cards	<i>[Signature]</i>
Tracing	<i>[Signature]</i>
France Map	<i>[Signature]</i>
Scarborough Map	<i>[Signature]</i>
Moody Map	<i>[Signature]</i>
Scarborough Plot Book	
Moody Plot Book	

Map No. 46 Sec. 33 Twp. 19 R. 10W

Well No. 1 Schertz "B"

Hartman & Blair Company

Contractor

SECTION PLAT

			0

_____ Ft. from N. Line

169 Ft. from S. Line

330 Ft. from E. Line

_____ Ft. from W. Line

COMPLETED

Location _____

Rig up _____

Drilling and Remarks:

Sil 3313 collected

P 8 1586

RECORD

Cased _____ in., _____ ft.

Sand _____

Gas _____

Oil _____

Total Depth 3335 1/2

PRODUCTION

1st 24 hrs. Nat. _____

1st 24 hrs. after shot _____

Gas _____ Cu. Ft.

Dry Hole _____

Abandoned _____

Date

SEP 30 1936 19

S. J. LEWIS

Scout

[Large handwritten signature]

Returned	<i>[Signature]</i>
Cards	<i>[Signature]</i>
Tracing	<i>[Signature]</i>
France Map	<i>[Signature]</i>
Scarborough Map	<i>[Signature]</i>
Moody Map	<i>[Signature]</i>
Scarborough Plat Book	
Moody Plat Book	