


Section 33 Township 19 Range 10-W

Well No. 2 Schartz "B"

Company Hartman & Blair

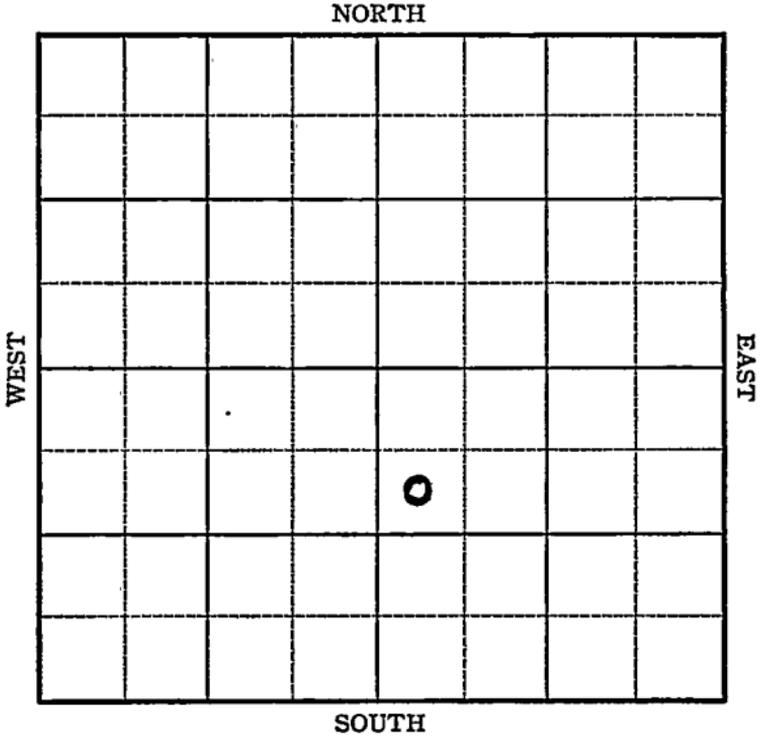

O. W. D. D


KANSAS

Rice

Sec. 33 Twp. 19 R. 10-7

Well No. #2 Schartz "B" Farm
Hartman & Blair Company

990 Ft. from N. Line
 _____ Ft. from S. Line
 _____ Ft. from E. Line
330 Ft. from W. Line

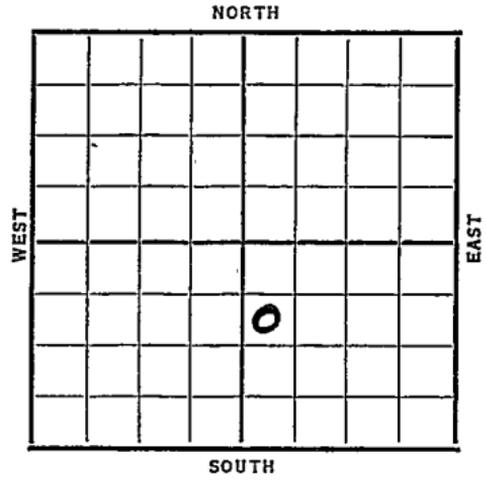

Date	REPORT	O. W. D. D
1937		
10/6	10" @ 131'. Drlg. 2950'.	
10/15	Cong. 3302'. Sil. 3319 & 7". No shows reported. RUST.	
10/22	T.D. 3351'. 500' water 48 hrs. P.B. 3333'. S.S.O. Will acidize.	
10/29	4000 acid.	
11/5	H.F.W. S.D.O.	
11/12	" " "	
11/19	" " "	
11/26	" " "	
12/1	7" @ 3319'. Sil. 3319'. T.D. 3351'. H.F.W. P.B. 3333'. 4000 acid.	
	ABANDONED	
	OVER	

1937

O.W.D.D

12/15

Old T.D. 3351'.
Deepening for salt water disposal.
Drlg. 3600'.

12/24

" "

12/31

Regan 3780'.
Pre-cambrian Schist 3805'.
T.D. 3920', Rng. liner.

1938

1/7

197' of 5" liner @ 3475'.
WOC.

1/14

" " " "

1/20

" " " "

1/26

OWDD for salt water disposal.
Regan 3780'.
Precambrian Chist 3805'.
T.D. 3920'.
197' of 5" liner at 3475'.
No input test.

ABANDONED

Rice KANSAS

Map No. _____ Sec. 33 Twp. 19 R. 10WWell No. 2 Schartz "B"Hartman & Blair Company

Contractor

FIRST REPORT**SECTION PLAT**

SW NW SE

990 Ft. from N. Line

_____ Ft. from S. Line

_____ Ft. from E. Line

330 Ft. from W. Line

		0	

Location _____

Rig up _____

Drilling and Remarks:

10" - 131Dlg - 2950**RECORD**

Cased _____ in., _____ ft.

Sand _____

Gas _____

Oil _____

Total Depth _____

PRODUCTION

1st 24 hrs. Nat. _____

1st 24 hrs. after shot _____

Gas _____ Cu. Ft.

Dry Hole _____

Abandoned _____

Date

OCT - 6 1937H. D. Hatfield Scout

Ray

Returned _____

Cards _____

Tracing _____

France Map _____

Scarborough Map _____

Mendot map _____

Scarborough Plat Book _____

Mendot Plat Book _____

Rice

KANSAS

Map No. 46 Sec. 33 Twp. 19 R. 10WWell No. 2 Scharitz "B"Hartman & Blair

Company

Contractor

ABANDONED

SW NW SE

990 Ft. from N. Line

_____ Ft. from S. Line

_____ Ft. from E. Line

330 Ft. from W. Line

SECTION PLAT

		0	

Location _____

Rig up _____

Drilling and Remarks:

HFW

P.B. 3333.

4000 Acid

DVA

RECORD

Cased 7 in., 3319 ft.Sand 511 3319

Gas _____

Oil _____

Total Depth 3351

PRODUCTION

1st 24 hrs. Nat. _____

1st 24 hrs. after shot _____

Gas _____ Cu. Ft.

Dry Hole _____


Abandoned _____

Date

DEC 1 - 1937

19

H. D. Hatfield Scout

 


P turned	
Ca de	<i>Paul</i>
Trac no	<i>Jan</i>
Frax	
Sea	<i>RAG</i>
Mod	
Search, sig. Book	
Mod, Plat Book	

Map No. 46 Sec. 33 Twp. 19 R. 10W

Well No. 2 Scharztz "B"

Hartman & Blair Company

Contractor

FIRST REPORT

SECTION PLAT

SW NW SE

990 Ft. from N. Line

_____ Ft. from S. Line

_____ Ft. from E. Line

330 Ft. from W. Line

		0	

Location _____

Rig up _____

Drilling and Remarks:

OWDD- Deepening
for Salt Water
Disposal

OTD. 3351

Drlg. 3600

RECORD

Cased _____ in., _____ ft.

Sand _____

Gas _____

Oil _____

Total Depth _____

PRODUCTION

1st 24 hrs. Nat. _____

1st 24 hrs. after shot _____

Gas _____ Cu. Ft.

Dry Hole _____

Abandoned _____

Date

DEC 15 1937

19

H. D. Hatfield

Scout

1947 4/10 2
1942 10/10 2

RM

Returned	
Cards	<i>Paul</i>
Tracing	<i>Joe</i>
France Map	
Scarborough Map	<i>Paul</i>
Moody Map	
Scarborough 1st Ed	
Moody F. 2 Ed	

Map No. 46 Sec. 33 Twp. 19 R. 10W

Well No. 2 Scharzt "B"

Hartman & Blair Company

~~CONTRACTED~~ Contractor

ABANDONED SECTION PLAT

SW NW SE

990 Ft. from N. Line

_____ Ft. from S. Line

_____ Ft. from E. Line

330 Ft. from W. Line

		0	

Location _____

Rig up _____

Drilling and Remarks:

*OWDD For
salt water disposal*

Regan 3780

*Pre Cambrian Chist
3805*

TD 3920 197' of

5" liner 3475

No input test

Date

RECORD

Cased _____ in., _____ ft.

Sand _____

Gas _____

Oil _____

Total Depth _____

PRODUCTION

1st 24 hrs. Nat. _____

1st 24 hrs. after shot _____

Gas _____ Cu. Ft.

Dry Hole _____

Abandoned _____

JAN 26 1938

19

H. D. Hatfield

Scout

[Handwritten signature]

[Handwritten signature]

Returned	
Cards	<i>[Handwritten signature]</i>
Tracing	<i>[Handwritten signature]</i>
France Map	
Scarborough Map	<i>[Handwritten signature]</i>
Moody Map	
Scarborough Plat Book	
Moody Plat Book	