


Section 33 Township 19 Range 9-W

Well No. #4 Dewitt

Company Cities Service Oil et al

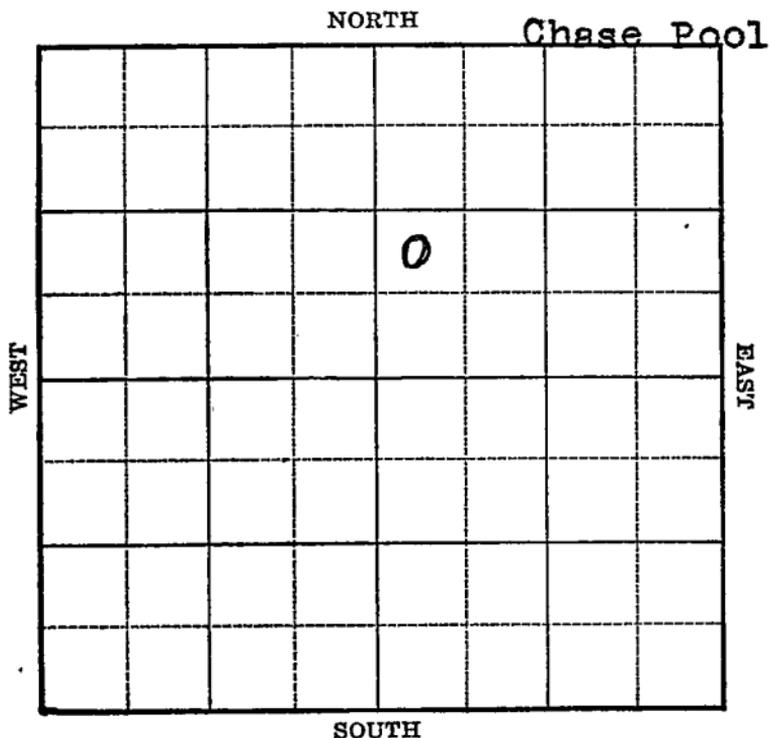



Map No. \_\_\_\_\_ Sec. 33 Twp. 19 R. 9WWell No. 4 DewittCities Service Oil et al Company

Contractor

## FIRST REPORT

NW SW NE

\_\_\_\_\_ Ft. from N. Line

990 Ft. from S. Line

\_\_\_\_\_ Ft. from E. Line

330 Ft. from W. Line

## SECTION PLAT

		o	

## CHASE POOL

Location X

Rig up \_\_\_\_\_

Drilling and Remarks: \_\_\_\_\_

## RECORD

Cased \_\_\_\_\_ in., \_\_\_\_\_ ft.

Sand \_\_\_\_\_

Gas \_\_\_\_\_

Oil \_\_\_\_\_

Total Depth \_\_\_\_\_

## PRODUCTION

1st 24 hrs. Nat. \_\_\_\_\_

1st 24 hrs. after shot \_\_\_\_\_

Gas \_\_\_\_\_ Cu. Ft.

Dry Hole \_\_\_\_\_

Abandoned \_\_\_\_\_

Date

JUN 21 1939 19S. J. LEWIS

Scout

Rice

KANSAS

Map No. 49 Sec. 33 Twp. 19 R. 9W

Well No. 4 Dewitt

Cities Service Oil etal Company

Contractor

**COMPLETED**

NW SW NE

\_\_\_\_\_ Ft. from N. Line

990 Ft. from S. Line

\_\_\_\_\_ Ft. from E. Line

330 Ft. from W. Line

CHASE POOL

**SECTION PLAT**

		o	

Location \_\_\_\_\_

Rig up \_\_\_\_\_

Drilling and Remarks \_\_\_\_\_

*Cor & 3187*  
*6" @ 3188.*  
*7000 acid*  
*Pump 55 ft.*

**RECORD**

Cased \_\_\_\_\_ in., \_\_\_\_\_ ft.

Sand \_\_\_\_\_

Gas \_\_\_\_\_

Oil \_\_\_\_\_

Total Depth 3227

**PRODUCTION**

1st 24 hrs. Nat. \_\_\_\_\_

1st 24 hrs. after shot \_\_\_\_\_

Gas \_\_\_\_\_ Cu. Ft.

Dry Hole \_\_\_\_\_

Abandoned \_\_\_\_\_

Date

AUG 9 1939 19

S. J. LEWIS Scout