



Sec. 33 Twp. 19 R. 9-W

Well No. #2 DeWitt Farm \_\_\_\_\_

Cities Service Oil et al Company

(Campbell)


990 Ft. from N. Line

\_\_\_\_\_ Ft. from S. Line

\_\_\_\_\_ Ft. from E. Line

330 Ft. from W. Line

Elev. 1688'

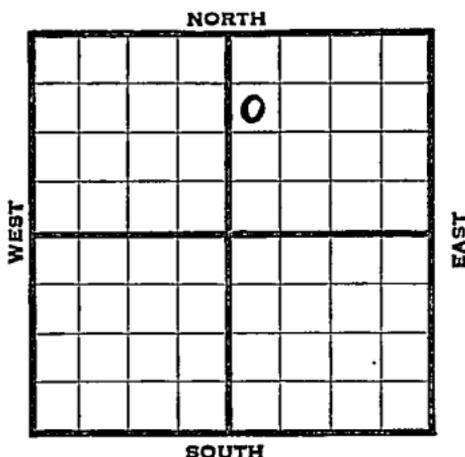

1939	REPORT
3/22	Mat'l.
3/31	8" - 200' Drlg. 1602'
4/7	Drlg. 3050'
4/14	Erosional Arb. 3182' Solid Arb. 3193-94' T.D. 5" - 3194' RUST.
4/21	T.D. 3217' 1875' oil.
4/28	5" - 3194'
	Arb. 3193'
	T. D. 3223'
	3000 acid.
	Pump 392 bbls. 8 hours.
	Potential 1116 bbls.
	<b>COMPLETED</b>

Rice

**KANSAS**

Map No. 49 Sec. 33 Twp. 19 R. 9W

Well No. 2 DeWitt

Cities Service Oil etal Company

~~FIRST REPORT~~ Contractor

**SECTION PLAT**

SW NW NE  
990 Ft. from N. Line  
 \_\_\_\_\_ Ft. from S. Line  
 \_\_\_\_\_ Ft. from E. Line  
330 Ft. from W. Line

		0	

**CAMPBELL POOL**

Location \_\_\_\_\_

Rig up \_\_\_\_\_

Drilling and Remarks:

Matl.

**RECORD**

Cased \_\_\_\_\_ in., \_\_\_\_\_ ft.

Sand \_\_\_\_\_

Gas \_\_\_\_\_

Oil \_\_\_\_\_

Total Depth \_\_\_\_\_

**PRODUCTION**

1st 24 hrs. Nat. \_\_\_\_\_

1st 24 hrs. after shot \_\_\_\_\_

Gas \_\_\_\_\_ Cu. Ft.

Dry Hole \_\_\_\_\_

Abandoned \_\_\_\_\_

Date

MAR 22 1939

E. D. Hatfield Scout

Map No. 49 Sec. 33 Twp. 19 R. 9WWell No. 2 DeWittCities Service Oil et al Company

Contractor

~~COMPLETED~~

SW NW NE

## SECTION PLAT

990 Ft. from N. Line

		0	

\_\_\_\_\_ Ft. from S. Line

\_\_\_\_\_ Ft. from E. Line

330 Ft. from W. Line

CAMPBELL POOL

Location \_\_\_\_\_

## RECORD

Rig up \_\_\_\_\_

Cased 5 in., 3194 ft.

Drilling and Remarks:

Sand Arb 3193

Gas \_\_\_\_\_

Oil \_\_\_\_\_

Total Depth 3223

## PRODUCTION

1st 24 hrs. Nat. \_\_\_\_\_

1st 24 hrs. after shot \_\_\_\_\_

Gas \_\_\_\_\_ Cu. Ft.

Dry Hole \_\_\_\_\_

Abandoned \_\_\_\_\_

3000 AcidP-392/8Pot 1116

Date

H. D. Hatfield Scout

APR 26 1939 19