


Section 33 Township 19 Range 9-W

Well No. #1 DeWitt

Company Cities Service Oil et al

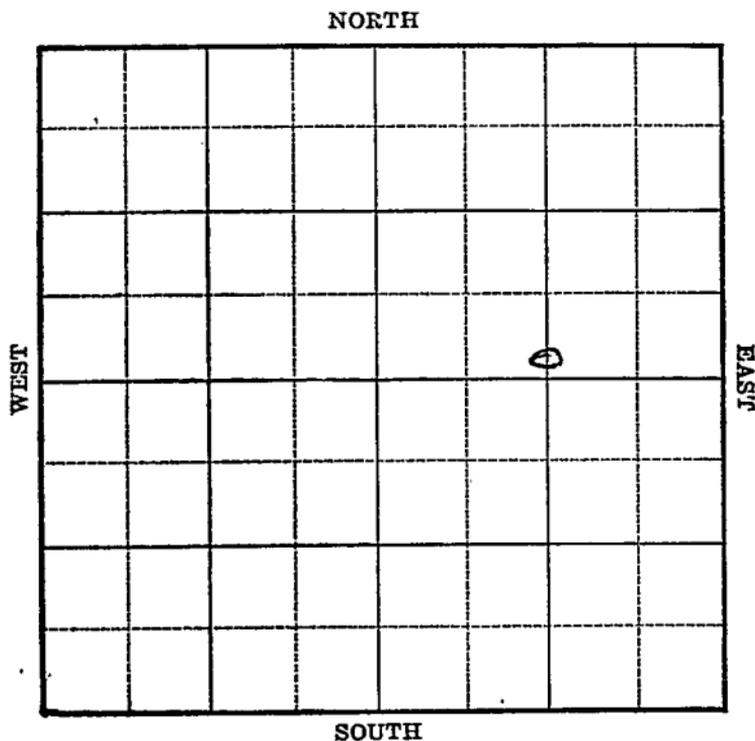

Sec. 33 Twp. 19 R. 9-W

Well No. #1 Dewitt Farm


Cities Service Oil et al Company

_____ Ft. from N. Line

440 Ft. from S. Line

1320 Ft. from E. Line

_____ Ft. from W. Line

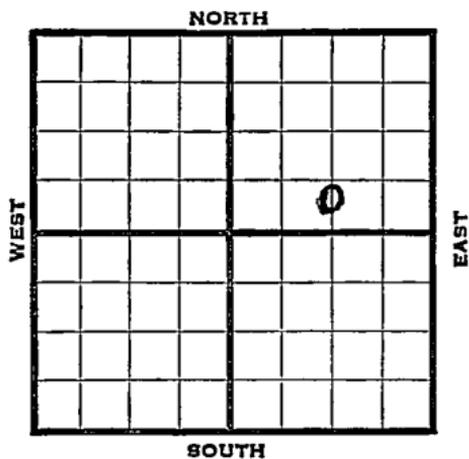

Elev. 1687

1938	REPORT
11/16	RUCT.
11/25	Spud.
12/2	15" - 605'. Drlg. 740'.
12/9	12" - 1530'. Drlg. 1535'.
12/15	Drlg. 1850'.
12/23	Fsg. 2065'.
12/30	10" - 2042'. Drlg. 2075'.
1939	
1/6	10" - 2290'. Drlg. 2340'.
1/13	Lans. 2859-77' T. D. 8" - 2877'. WOC.
1/20	Arb. 3174' T.D. 7" - 3174'. WOC.
1/27	Drilled plug. S. O. 3181'. At 3185' filled 1500' oil. 2800' oil 3 hrs. Inc. oil 3189- 3192'.
	OVER

1939

2/1

7" - 3174'.

Arb. 3174'.

T. D. 3195'.

Pump 513 bbls. 8 hrs.

Potential 1540 bbls. Nat'l.

Gravity 48.5 at 60. .

COMPLETED

Map No. 49 Sec. 33 Twp. 19 R. 9WWell No. 1 DeWittCities Service Oil etal Company

Contractor

FIRST REPORT

C S L N E

SECTION PLAT

			o

_____ Ft. from N. Line

440 Ft. from S. Line1320 Ft. from E. Line

_____ Ft. from W. Line

Location _____

Rig up _____

Drilling and Remarks:

RUCT

RECORD

Cased _____ in., _____ ft.

Sand _____

Gas _____

Oil _____

Total Depth _____

PRODUCTION

1st 24 hrs. Nat. _____

1st 24 hrs. after shot _____

Gas _____ Cu. Ft.

Dry Hole _____


Abandoned _____

Date

NOV 16 1938

19

H. D. Hatfield Scout

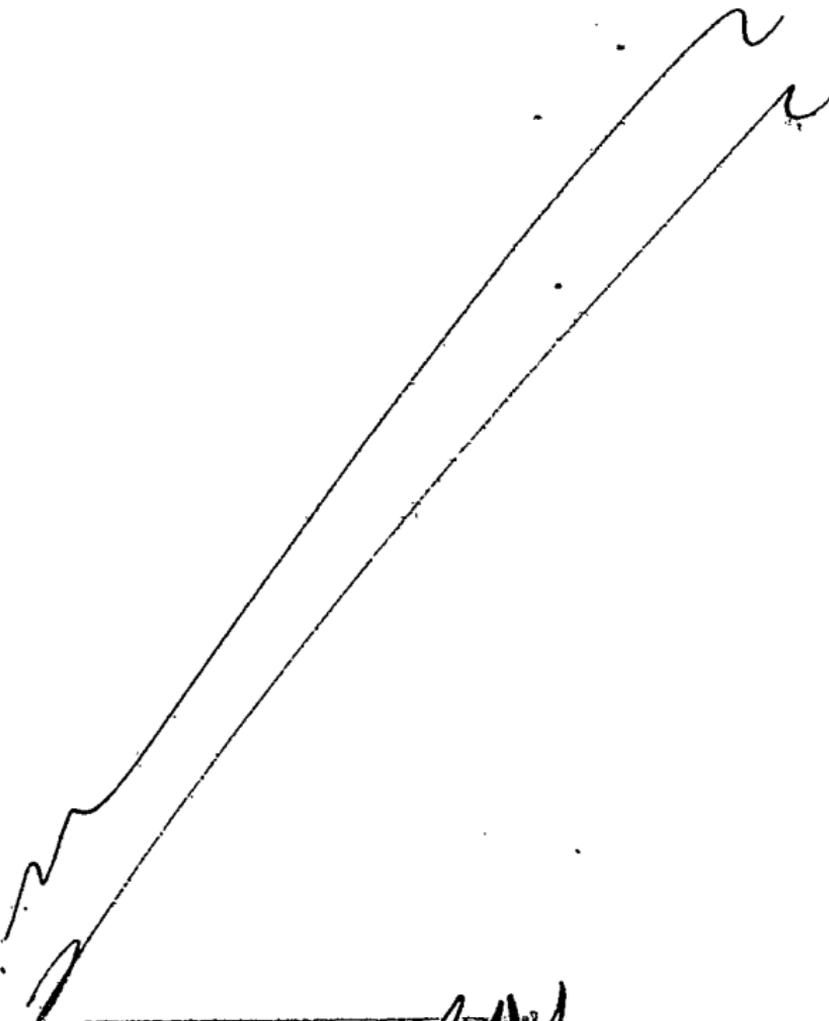

Misc Small Papers	<i>RAY</i>
Cards	<i>Paul</i>
Tracing	<i>Paul</i>
France Map	<i>X</i>
Source of Map	<i>RAY</i>
Moody Map	<i>X</i>
Ce 'logical Dept	<i>—</i>
Moody Flat Book	

Rice

KANSAS

Map No. _____ Sec. 33 Twp. 19 R. 9WWell No. 1 DeWittCities Service Oil et al Company

Contractor

COMPLETED

C S L NE

SECTION PLAT

_____ Ft. from N. Line

440 Ft. from S. Line1320 Ft. from E. Line

_____ Ft. from W. Line

			○

WILDCAT

No Name For Pool

Location _____

Rig up _____

Drilling and Remarks:

P-513/8Pot 1540
NATgrau 48.5/60**RECORD**Cased 7 in., 3174 ft.Sand ARB 3174

Gas _____

Oil _____

Total Depth 3195**PRODUCTION**

1st 24 hrs. Nat. _____

1st 24 hrs. after shot _____

Gas _____ Cu. Ft.

Dry Hole _____

Abandoned _____

Date

H. D. Hatfield

FEB 1 - 1939 ¹⁹

Scout

Misc Small Maps
Cards
Tracing
France Map
Scarborough Map
Moody Map
Geological Dept.
Moody Flat Book