

KANSAS


Form 51-5M-7-40-Palace

Rice

Section 33 Township 19 Range 9-W

Well No. #1 Abel

Company Cities Service Oil

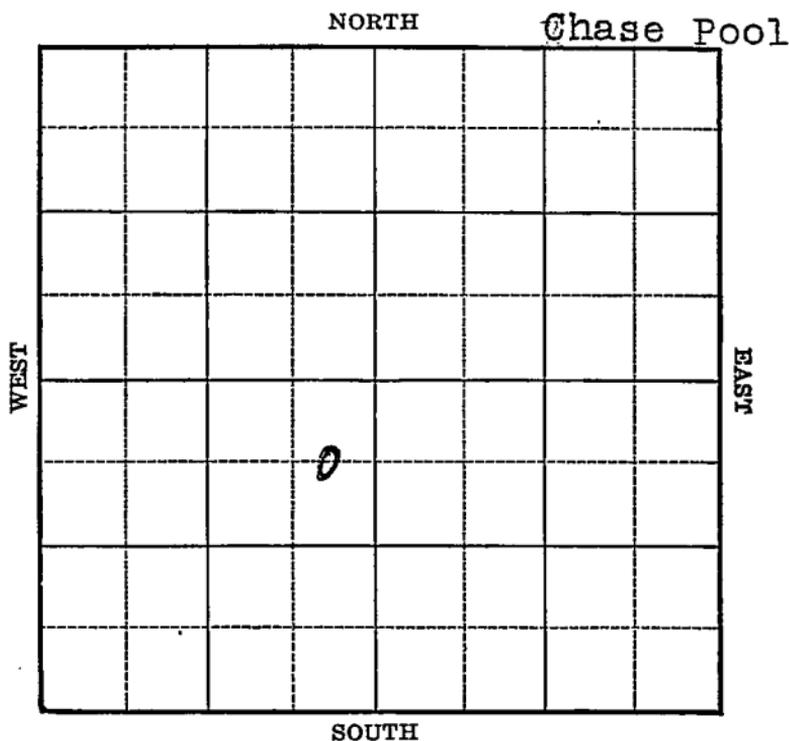

Sec. 33 Twp. 19 R. 9-W

Well No. #1 Abel Farm _____

Cities Service Oil Company _____

(Chase)


660 Ft. from N. Line

_____ Ft. from S. Line

330 Ft. from E. Line

_____ Ft. from W. Line

Elev. 1694

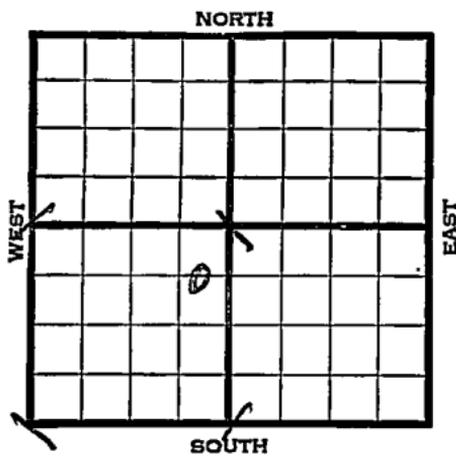

1940	REPORT
12/4	Location
12/12	8" - 250' Drlg. 350'
12/19	Drlg. 3188'
12/23	Arb. 3227'
	T.D. 3253'
	No shows.
	ABANDONED

Map No. 49 Sec. 33 Twp. 19 R. 9WWell No. 1 Abel

Cities Service Oil Company


~~FIRST REPORT~~ Contractor

C E L NE SW

660 Ft. from N. Line Ft. from S. Line330 Ft. from E. Line Ft. from W. Line

CHASE POOL

SECTION PLAT

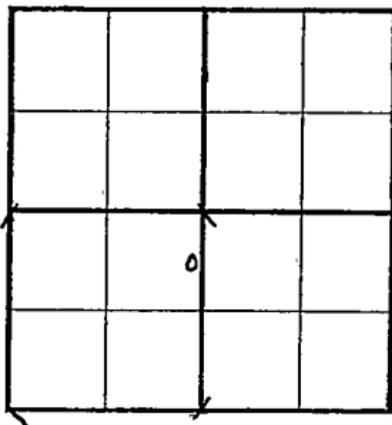Location XRig up

Drilling and Remarks:

RECORD

Cased in., ft.Sand Gas 'Oil Total Depth

PRODUCTION

1st 24 hrs. Nat. 1st 24 hrs. after shot Gas Cu. Ft.Dry Hole Abandoned

Date

DEC 4 1940 19S. I. LEWIS Scout

Map No. 49 Sec. 33 Twp. 19 R. 9WWell No. 1 AbelCities Service Oil Company

Contractor

ABANDONED**SECTION PLAT**

C E L N E SW

660 Ft. from N. Line

_____ Ft. from S. Line

330 Ft. from E. Line

_____ Ft. from W. Line

CHASE POOL

Location _____

Rig up _____

Drilling and Remarks:


Cased _____ in., _____ ft.

Sand _____

Gas _____

Oil _____

Total Depth 3253**PRODUCTION**

1st 24 hrs. Nat. _____

1st 24 hrs. after shot _____

Gas _____ Cu. Ft.

Dry Hole _____

Abandoned _____

Date

DEC 23 1940 19S. I. LEWIS

Scout