

Section 33 Township 19 Range 9W

Well No. 1 Apel

Company Skelly

Chase Pool  
NORTH

WEST							EAST
0							

SOUTH

KANSAS

Rice



Sec. 33 Twp. 19 R. 9W

Well No. #1 Apel Farm

Skelly

Company

Chase Pool


330' Ft. from N. Line

\_\_\_\_\_ Ft. from S. Line

\_\_\_\_\_ Ft. from E. Line

330' Ft. from W. Line

NW SW

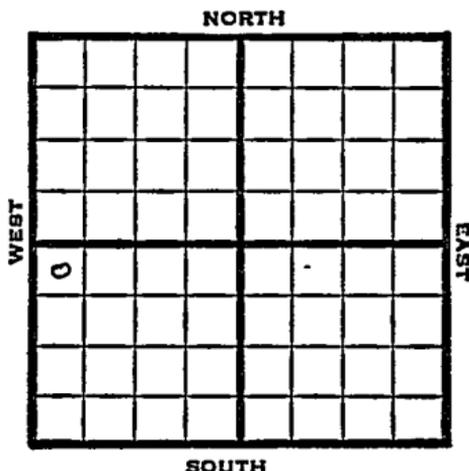

1948 Elev 1701' REPORT

11/23 Location  
 11/30 "  
 12/6 8" @ 312'  
 Drlg. 1400'  
 12/15 Lansing 2900'  
 Arb. 3236-45'  
 TD 3245  
 Run 5"  
 12/22 5" @ 3238'  
 12/29 "  
 1949  
 1/12 TD 3252'  
 Arb. 3236'  
 5" @ 3238'  
 Aband.

**ABANDONED**

Map No. \_\_\_\_\_ Sec. 33 Twp. 19 R. 9W

Well No. 1 Apel

Skelly Company

**FIRST REPORT** Contractor

NW SW


**SECTION PLAT**

330 Ft. from N. Line

\_\_\_\_\_ Ft. from S. Line

\_\_\_\_\_ Ft. from E. Line

330 Ft. from W. Line

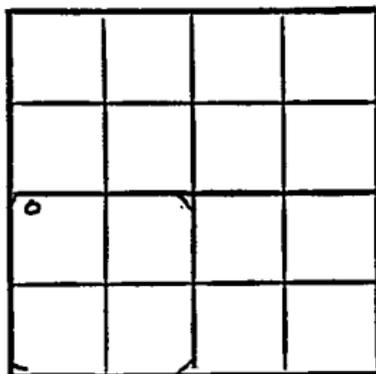

Rice County

Location X

Rig up \_\_\_\_\_

Drilling and Remarks:

**RECORD**

Cased \_\_\_\_\_ in., \_\_\_\_\_ ft.

Sand \_\_\_\_\_

Gas \_\_\_\_\_

Oil \_\_\_\_\_

Total Depth \_\_\_\_\_

**PRODUCTION**

1st 24 hrs. Nat. \_\_\_\_\_

1st 24 hrs. after shot \_\_\_\_\_

Gas \_\_\_\_\_ Cu. Ft.

Dry Hole \_\_\_\_\_

Abandoned \_\_\_\_\_

Date

NOV 23 1948 19 \_\_\_\_\_

S. J. LEWIS Scout

Map No. 40 Sec. 33 Twp. 19 R. 9W

Well No. 1 Apel

Skelly Company

**ABANDONED**

Contractor

NW SW

*E1, 1701*  
SECTION PLAT

330 Ft. from N. Line

         Ft. from S. Line

         Ft. from E. Line

330 Ft. from W. Line

o			

Rice County

**RECORD**

Location                                 

Cased          in.,          ft.

Rig up                                 

Sand                                 

Drilling and Remarks:

Gas                                 

*Out 3286  
5" 3288*

Oil                                 

Total Depth 3252

**PRODUCTION**

1st 24 hrs. Nat.                         

1st 24 hrs. after shot                         

Gas                                  Cu. Ft.

Dry Hole                                 

Abandoned                                 

Date

JAN 12 1949 19

S. J. LEWIS Scout