

Rice


KANSAS

FORM 51 25M 3-49 PETROL

Section 33 Township 19 Range 9 W

Well No. # 8 DeWitt

Company Cities Service

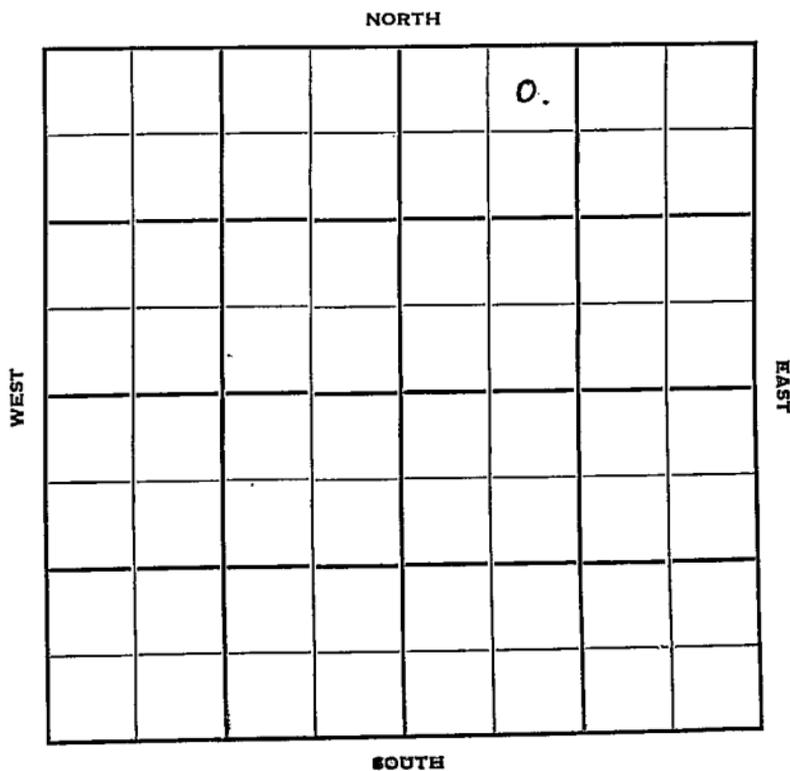

Rice

KANSAS

Sec. 33 Twp. 19 R. 9 W

Well No. # 8 DeWitt Farm

Cities Service Company

Chase Pool


330 Ft. from N. Line

_____ Ft. from S. Line

_____ Ft. from E. Line

990 Ft. from W. Line

NE NW NE

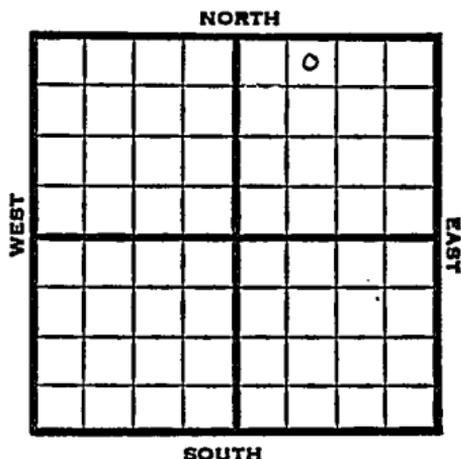

1951

Elev. 1685' REPORT

10/3

Spud 9-30-51
8" @ 226
Drilling 1790'

11/7

Spud 9-30-51
D&A TD 3215
8" @ 226
Lans. 2866 Cong. 3171
Arb. 3188 TD 3192
5" @ 3189 DD 3215
FU 1000' wtr 4 hr.
PB 3209 1000 A
P 10 bo 46 bw 20 hr.
P/4 bo 56 bwpd PB 3205
D&A

ABANDONED

