

KANSAS


Rice


Form 51-5M-7-40-Palace

Section 33 Township 19 Range 9-W

Well No. #6 DeWitt

Company Cities Service Oil, et al

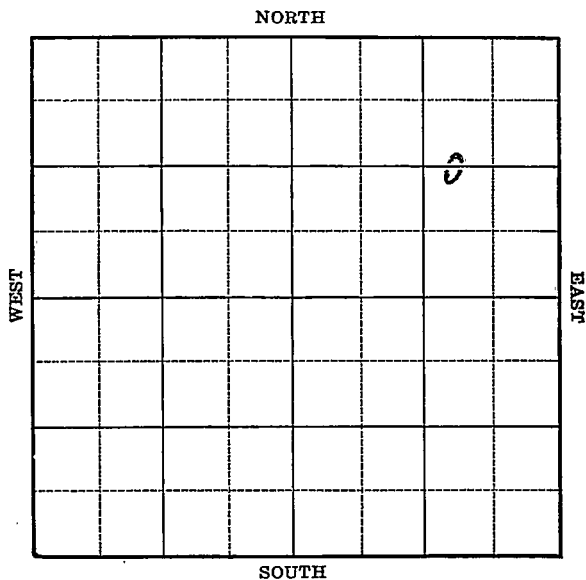

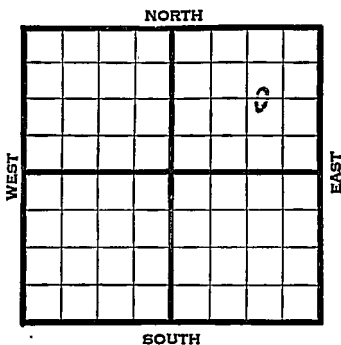

COMPLETED

Map No. 409 Sec. 33 Twp. 19 R. 9WWell No. 6 DeWittCities Service Oil et al Company

Contractor

FIRST REPORT

C W L E $\frac{1}{2}$ NE1320 Ft. from N. Line Ft. from S. Line990 Ft. from E. Line Ft. from W. Line

CHASE POOL

SECTION PLAT

Location Rig up

Drilling and Remarks:

8" - 212
WOC

RECORD

Cased in., ft.Sand Gas Oil Total Depth

PRODUCTION

1st 24 hrs. Nat. 1st 24 hrs. after shot Gas Cu. Ft.Dry Hole Abandoned

Date

SEP 11 1940

19

S. J. LEWIS Scout

Map No. 49 Sec. 33 Twp. 19 R. 9WWell No. 6 DeWittCities Service Oil et al Company

Contractor

COMPLETEDC W L E $\frac{1}{2}$ NE1320 Ft. from N. Line Ft. from S. Line990 Ft. from E. Line Ft. from W. Line

CHASE POOL

SECTION PLAT

			e

Location Rig up

Drilling and Remarks:

*Per 88174**5 "C 3175"**6000 acrol**Ech. P. 1095***RECORD**Cased in., ft.Sand Gas Oil Total Depth 3209**PRODUCTION**1st 24 hrs. Nat. 1st 24 hrs. after shot Gas Cu. Ft.Dry Hole Abandoned

Date

OCT 2 1940 19S. J. LEWIS Scout