

KANSAS


Form 51—5M—11-38—Palace

Rice

Section 33 Township 19 Range 9-W


Well No. #5 Dewitt

Company Cities Service Oil et al

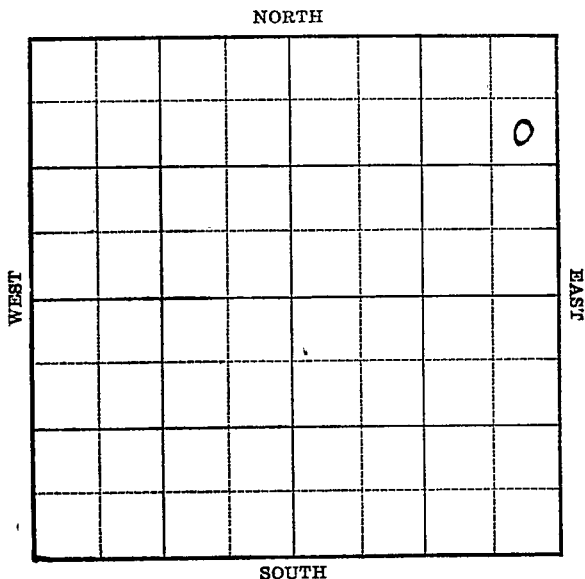

Company

Elev. 1682

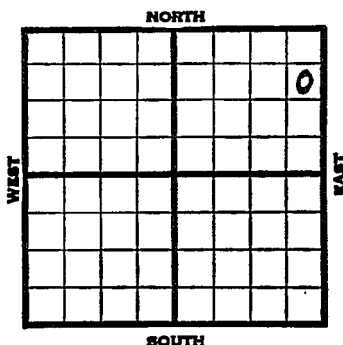[illegible]

Rice

KANSAS

Map No. _____ Sec. 33 Twp. 19 R. 9WWell No. 5 DewittCities Service Oil etal Company

Contractor _____

FIRST REPORT

SE NE NE

990 Ft. from N. Line

_____ Ft. from S. Line

330 Ft. from E. Line

_____ Ft. from W. Line

CHASE POOL

SECTION PLAT

			o

Location _____

Rig up _____

Drilling and Remarks:

10" - 244

WOC

RECORD

Cased _____ in., _____ ft.

Sand _____

Gas _____

Oil _____

Total Depth _____

PRODUCTION

1st 24 hrs. Nat. _____

1st 24 hrs. after shot _____

Gas _____ Cu. Ft.

Dry Hole _____

Abandoned _____

Date

SEP 20 1939

19

S. J. LEWIS Scout

Rice

KANSAS

Map No. 49 Sec. 33 Twp. 19 R. 9WWell No. 5 Dewitt

Cities Service Oil et al Company

Contractor

COMPLETED

SECTION PLAT

			e

SE NE NE

990 Ft. from N. Line

_____ Ft. from S. Line

330 Ft. from E. Line

_____ Ft. from W. Line

CHASE POOL

Location _____

Rig up _____

Drilling and Remarks:

*CR 8 3163**1" @ 3164**2000 acid**Echometer P.S.**2500*

RECORD

Cased _____ in., _____ ft.

Sand _____

Gas _____

Oil _____

Total Depth 8194

PRODUCTION

1st 24 hrs. Nat. _____

1st 24 hrs. after shot _____

Gas _____ Cu. Ft.

Dry Hole _____

Abandoned _____

Date

OCT 11 1939 19 S. J. LEWIS Scout