

KANSAS


Rice

Form 51-5M-7-39-Palace

Section 33 Township 19 Range 9-W

Well No. #2 Pulliam "C"

Company Cities Service Oil et al

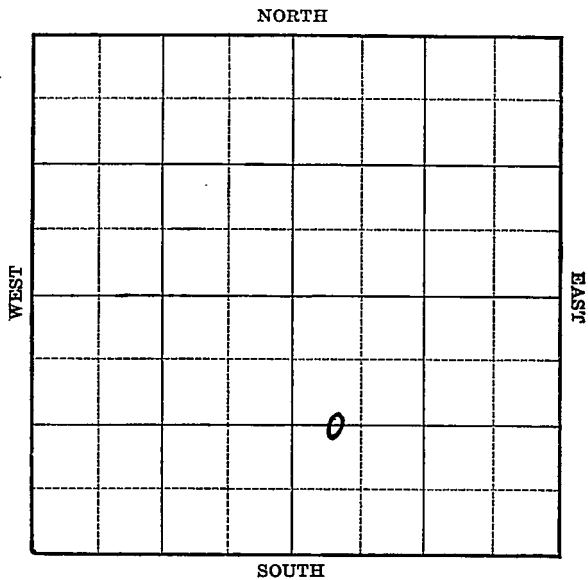


KANSAS

Rice

Sec. 33 Twp. 19 R. 9-WWell No. #2 Pulliam "C" FarmCities Service Oil et al Company

(Chase)

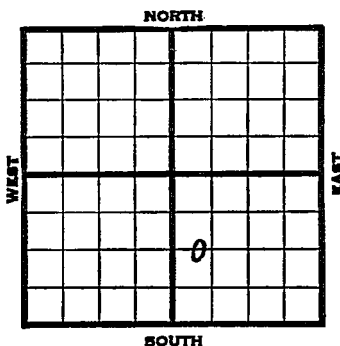 Ft. from N. Line1320 Ft. from S. Line Ft. from E. Line440 Ft. from W. LineElev 1690

REPORT

1939

12/6

Location

12/14

Rotary.

12/21

8" - 205' Drlg. 605'

12/28

Drlg. 1315'

1940

1/4

Cong. 3190' Arb. 3235'

T.D. 3261' S.W. Shut down.

1/11

T.D. 3424' Fsg. 5".

Will make a salt water disposal well.

1/17

Arb. 3235' water.

T.D. 3424'

ABANDONED

Rice

KANSAS

Map No. 49 Sec. 33 Twp. 19 R. 9WWell No. 2 Pulliam

Cities Service Oil et al Company

Contractor

FIRST REPORT

SECTION PLAT

C W L SE

_____ Ft. from N. Line

1320 Ft. from S. Line

_____ Ft. from E. Line

440 Ft. from W. Line

CHASE POOL

Location X

Rig up _____

Drilling and Remarks:

RECORD

Cased _____ in., _____ ft.

Sand _____

Gas _____

Oil _____

Total Depth _____

PRODUCTION

1st 24 hrs. Nat. _____

1st 24 hrs. after shot _____

Gas _____ Cu. Ft.

Dry Hole _____

Abandoned _____

Date

DEC 6 1939

S. J. LEWIS Scout

Rice KANSAS

Map No. 49 Sec. 33 Twp. 19 R. 9WWell No. 2 Pulliam "C"

Cities Service Oil etal Company

CORRECTION

Contractor

C W L SE

SECTION PLAT

 Ft. from N. Line1320 Ft. from S. Line Ft. from E. Line440 Ft. from W. Line

CHASE POOL

RECORD

Location Cased in., ft.Rig up Sand

Drilling and Remarks:

Gas

Reported as:

Oil Total Depth

#1 Pulliam

PRODUCTION

1st 24 hrs. Nat. 1st 24 hrs. after shot Gas Cu. Ft.Dry Hole Abandoned

Date

DEC 13 1939 19

S. J. LEWIS Scout

Rice

KANSAS

Map No. 49 Sec. 33 Twp. 19 R. 9WWell No. 2 Pulliam "C"Cities Service Oil et al Company

Contractor

ABANDONED

C W L SE

SECTION PLAT

 Ft. from N. Line1320 Ft. from S. Line Ft. from E. Line440 Ft. from W. Line

CHASE POOL

Location Rig up

Drilling and Remarks:

*Cu #3285.**Waled.*

RECORD

Cased in., ft.Sand Gas Oil Total Depth 3424

PRODUCTION

1st 24 hrs. Nat. 1st 24 hrs. after shot Gas Cu. Ft.Dry Hole Abandoned

Date

JAN 17 1940 19

S. J. LEWIS Scout