

Section 33 - Township 19 Range 9W

Well No. 2 Purcell

Company: J.C. Dozier

Chase Pool

NORTH

WEST

EAST

SOUTH

A 10x10 grid with 'WEST' on the left, 'EAST' on the right, and 'SOUTH' at the bottom. A small circle is in the second row, second column from the left.

KANSAS

Rice

Sec. 33 Twp. 19 R. 9W

Well No. #2 Purcell Farm

J. G. Dozier Company

Chase Pool


990' Ft. from N. Line

 Ft. from S. Line

 Ft. from E. Line

990' Ft. from W. Line

SE NW NW

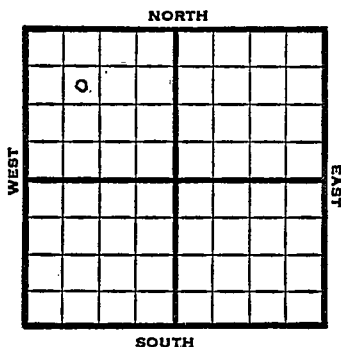

1948

Elev. 1695' REPORT

12/8

8" @ 192'

Drlg. 1694'

12/14

Arb. 3310-

TD 3312

5" @ 3310

12/22

Arb 3210'

5" @ 3210'

Pump 50 oil Pot.

Gr. 420

TD 3215'

COMPLETED

Map No. _____ Sec. 33 Twp. 19 R. 9W

Well No. 2 Purcell

J. C. Doyier Company

FIRST REPORT Contractor

SE NW NW

990 Ft. from N. Line

_____ Ft. from S. Line

_____ Ft. from E. Line

990 Ft. from W. Line

Rice County

SECTION PLAT

a			

Location _____

Rig up _____

Drilling and Remarks:

8" @ 192

drlg. 1694

RECORD

Cased _____ in., _____ ft.

Sand _____

Gas _____

Oil _____

Total Depth _____

PRODUCTION

1st 24 hrs. Nat. _____

1st 24 hrs. after shot _____

Gas _____ Cu. Ft.

Dry Hole _____

Abandoned _____

Date

DEC 8 1948 19 S. J. LEWIS Scout

Map No. 49 Sec. 33 Twp. 19 R. 9WWell No. 2 PurcellJ. C. Dozier

Company

COMPLETE


Contractor

SE NW NW

E 11695
SECTION PLAT990 Ft. from N. Line

Ft. from S. Line

Ft. from E. Line

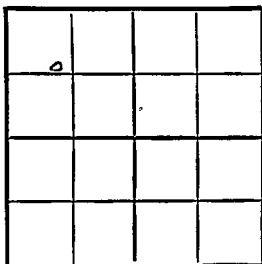990 Ft. from W. Line

Rice County

RECORD

Location

Cased _____ in. _____ ft.

Rig up

Sand _____

Drilling and Remarks:

Gas _____

Oil ☒Total Depth 2215

PRODUCTION

1st 24 hrs. Nat. _____

1st 24 hrs. after shot _____

Gas _____ Cu. Ft.

Dry Hole _____

Abandoned _____

Date

DEC 22 1948

19

S. J. LEWIS

Scout