

KANSAS


Rice

Section 33 Township 19 Range 9W

Well No. 3 Purcell

Company J.C. Dozier

Chase
NORTH

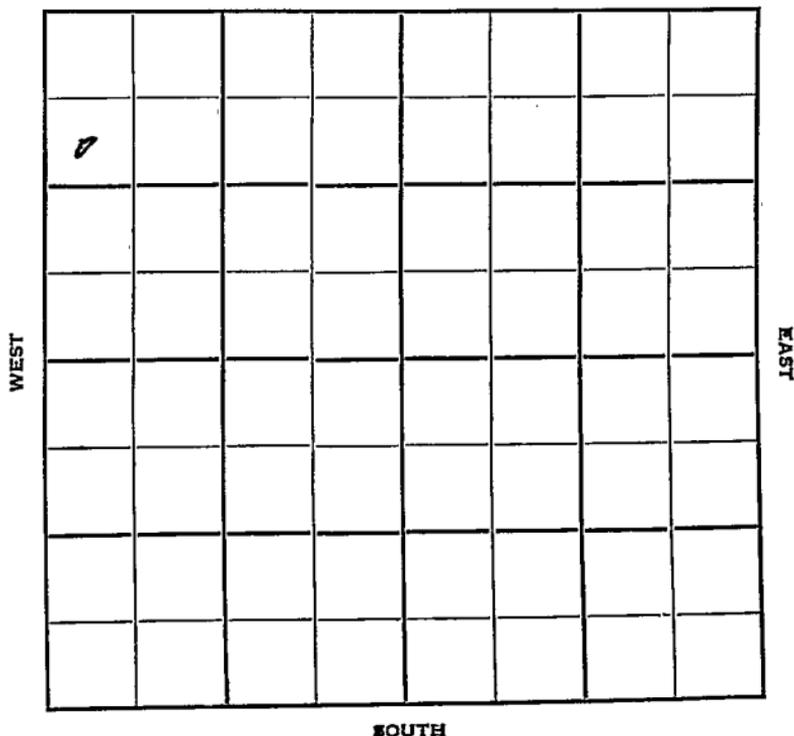

KANSAS Rice

Sec. 33 Twp. 19 R. 9W ✓

Well No. #3 Purcell Farm

J. C. Dozier Company


Chase Pool (Lewis, Cont.)

990' Ft. from N. Line

_____ Ft. from S. Line

_____ Ft. from E. Line

330' Ft. from W. Line

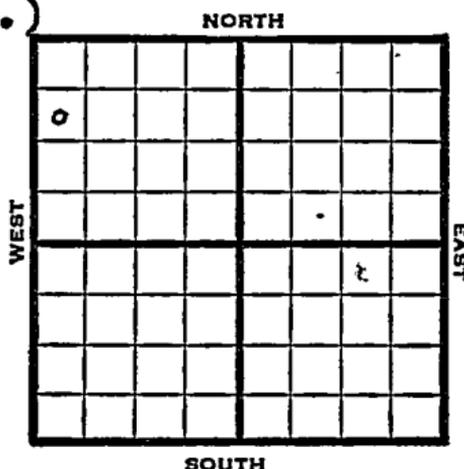

SW NW NW

1949

Elev. 3227' ? REPORT

6/22

8" @ 171'

6/28

Arb. 3207-08'

TD 3208'

5" @ 3207'

7/6

"

7/12

"

7/20

Complete

Arb. 3207'

5" @ 3207'

Pump 50 oil pot.

TD 3227'

COMPLETED

Map No. _____ Sec. ⁴ 33 Twp. 19 R. 9W

Well No. 3 Purcell

J. C. Dozier Company

Lewis Contractor

SW NW NW

FIRST REPORT
SECTION PLAT

990 Ft. from N. Line

_____ Ft. from S. Line

_____ Ft. from E. Line

330 Ft. from W. Line

o			

Rice County

Location _____

Rig up _____

Drilling and Remarks:

8" @ 171

RECORD

Cased _____ in., _____ ft.

Sand _____

Gas _____

Oil _____

Total Depth _____

PRODUCTION

1st 24 hrs. Nat. _____

1st 24 hrs. after shot _____

Gas _____ Cu. Ft.

Dry Hole _____

Abandoned _____

Date

JUN 22 1949 19

S. J. LEWIS Scout

