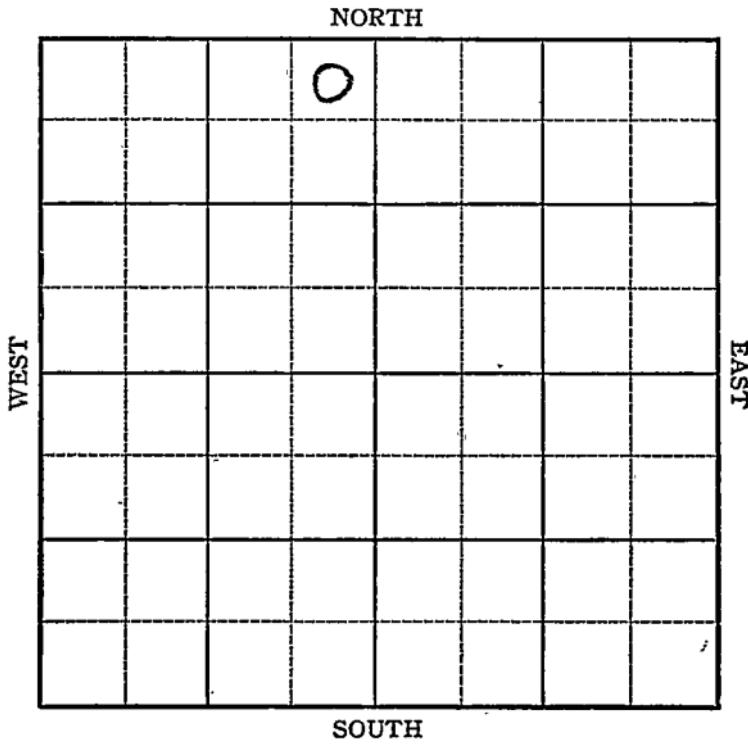


KANSAS

FORM 51 5M 6-46 PETROL

Rice County

Section 33 Township 19 Range 9WWell No. 1 PurcellCompany Bay Petroleum

KANSAS

Rice County

Sec. 33 Twp. 19 R. 9W

Well No. #1 Purcell Farm

Bay Pet.

Company

Chase


330 Ft. from N. Line

Ft. from S. Line

330 Ft. from E. Line

Ft. from W. Line

NE NW

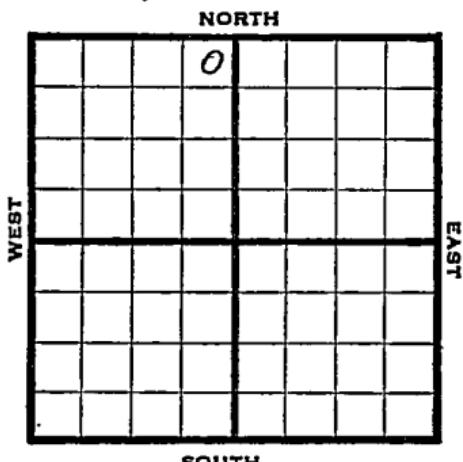

1946

Elev. 1693

R E P O R T

8/7	10" @ 197' WOC
8/13	Arb 3216 TD 3219 5" @ 3218' RUST
8/20	TD 3251-500 acid
8/28	ARB 3216' TD 3274 5" @ 3218'

ABANDONED


Kansas Pool Name Chase PoolKANSASMap No. 79 Sec. 33 Twp. 19 R. 9WWell No. 1 PurcellBay Pet.

Company

ABANDONED

Contractor

NE NW

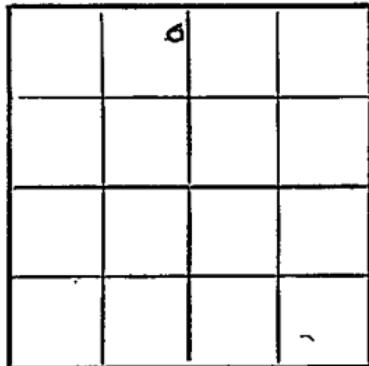E, 1/16 83
SECTION PLAT330 Ft. from N. Line

Ft. from S. Line

330 Ft. from E. Line

Ft. from W. Line

Rice County

Location _____

RECORD

Rig up _____

Cased in, ft.

Drilling and Remarks:

Sand _____

Gas _____

Oil _____

Total Depth 3274 _____Drill 82165" C8217**PRODUCTION**

1st 24 hrs. Nat. _____

1st 24 hrs. after shot _____

Gas Cu. Ft. _____

Dry Hole _____

Abandoned _____

Date

AUG 28 1946 19S. J. LEWIS Scout